

CERTIFIED LAND CORNER RESTORATION

Index No. **Q-9**



State of Wisconsin

County of Oneida } ss.

I Phillip T. Hansen, do hereby certify that on the 1st day of December, 1975, I found evidence of the S-1/16 corner of Section 20, and 21 Township 36, North, Range 10 East, Fourth Principal Meridian, as described hereon; and that from this evidence I established a new monument and accessories as described hereon to perpetuate the original location of this corner.

Resident witnesses:

Glen Barker
Jim Claflin

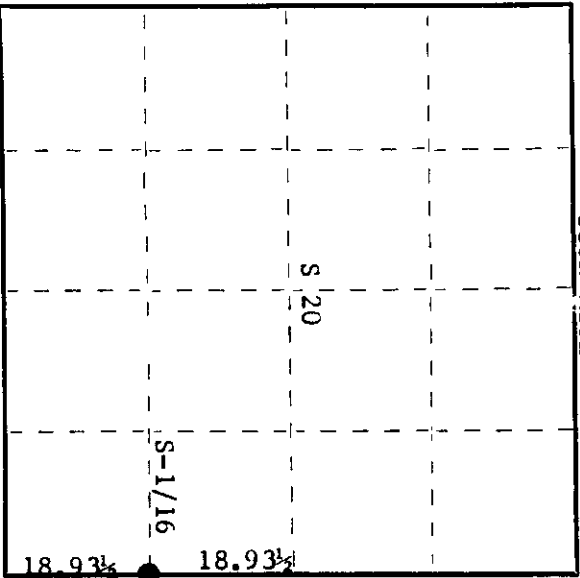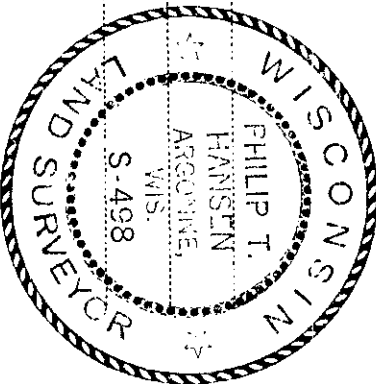

○ = Corner monument restored.

History of original corner establishment: Corner established by H.C. Lawrence, Registered Land Surveyor, in 1948. He commenced at section corner 20, 21, 28, 29 and ran N10°W a distance of 37.87 links to the 1/4 corner recovered and restored. Set S-1/16 at 18.93½ chains equidistant. As this corner fell in the road, he marked corner with a bolt with 1" square nut on top driven in flush with surface and set a witness corner 15 links West.

Marked NBT's - Spruce pine 12" N73°W 51 links
Spruce pine 9" East 70½ links

Description of corner evidence found: Recovered 1" iron bolt with square nut buried in the center line of old highway 8. No trace was found of Lawrence's witness post.

Recovered OBT's - Spruce pine (jack) 12" (15") N77°W 51 links scribed S-1/16 S20
Spruce pine (jack) 9" (11") N86°E 70.5 links scribed S-1/16 S21

Measurements and bearings to BT's were from iron bolt.

Description of monument and accessories I established to perpetuate the original location of this corner.
Set a 1-1/2" iron pipe with brass cap, projecting 16" above ground, stamped -S498
60 links West of the true corner.
T36N R10E

No NBT's were established. S-1/16 S20 S21 W.C.

W.C. and OBT's painted blue.

E-60 links

Dated at Rhineland, Wis., this 8th day of December, 1975.

Signature Phillip T. Hansen Title Registered Land Surveyor Registration No. S-498
(County Surveyor, Registered Land Surveyor, or other duly authorized official)

Office of Register of Deeds, County of Oneida, I hereby certify that the within instrument was filed in this office for record on the 4th day of January, 1976 at 10:00 o'clock A.M.

James M. Krueger
(Register of Deeds)

By: _____ Deputy

3610201000