

CERTIFIED LAND CORNER RESTORATION



Index No. Q-6

State of Wisconsin }
County of Oneida } ss.

I Phillip T. Hansen, do hereby certify that on the 4th day of May, 19 79, I ~~found~~ established the SW 1/16 corner of Section 20 Township 36 North, Range 10 East, Fourth Principal Meridian, as described hereon; and that from this evidence I established a new monument and accessories as described hereon to perpetuate the original location of this corner.

Resident witnesses:

Glen Barker
Jim Claflin
Herb Wagoner

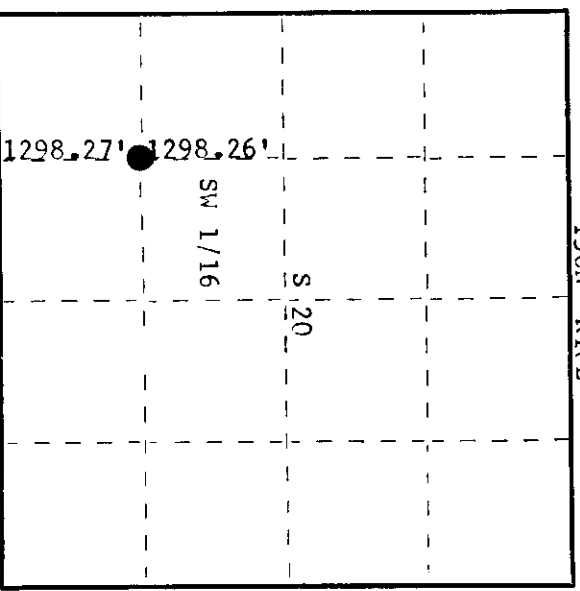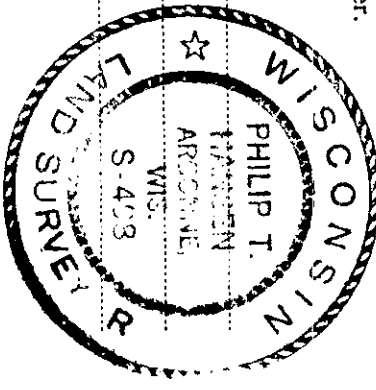

○ = Corner monument restored.

History of original corner establishment:
No records of any previous survey.

Description of corner evidence found:
No evidence of any corner recovered.

Corner established by traverse and computation. Computed distance from W 1/16 between Sections 20 and 29 to WC 1/16 corner is N 0° 19' 10" E 2596.528 feet. Computed location of SW 1/16 corner at 1298.27' N 0° 19' 10" E of W 1/16 and S 0° 19' 10" W 1298.26' of WC 1/16.

Description of monument and accessories I established to perpetuate the original location of this corner.
Set a 1-1/2" iron pipe with 2" brass cap, projecting 18", stamped:

Marked NBT's -
W.Fine 14" N51°E 48.29' scribed 1/16 BT.
R.Fine 6" S70°E 103.0' scribed 1/16 BT.
S498
T36N R10E
SW 1/16 S 20
CPI-1979

Dated at Rhineland Wis., this 14th day of May, 19 79

Signature Phillip T. Hansen Title Registered Land Surveyor Registration No. S-498
(County Surveyor, Registered Land Surveyor, or other duly authorized official)

Office of Register of Deeds, County of Oneida Thereby certify that the within instrument was filed in this office for record on the 13th day of June, 19 79 at 2:00 o'clock M.

Gene W. Hager
(Register of Deeds)

By Phillip T. Hansen Deputy

3610201030