

CERTIFIED LAND CORNER RESTORATION

Index No. P-8

State of Wisconsin }
County of Oneida } ss.

History of original corner establishment:
No records of any previous survey.


I Phillip T. Hansen, do hereby
certify that on the 3rd day
of March, 1979, I ~~surveyed~~
established the EC 1/16
corner of Section 20
Township 36, North, Range
10 East, Fourth Principal Meridian,

as described hereon; and that from this evidence
I established a new monument and accessories
as described hereon to perpetuate the original
location of this corner.


Description of corner evidence found:
No evidence of any corner recovered. Corner established by traverse and computation.
C 1/4 corner established at point 2616.745 feet S 89° 14' 33" W of E 1/4 corner. EC 1/16
corner established at 1308.37' intermediate.

Resident witnesses:

Glen Barker
Jim Clafflin
Herb Wagoner

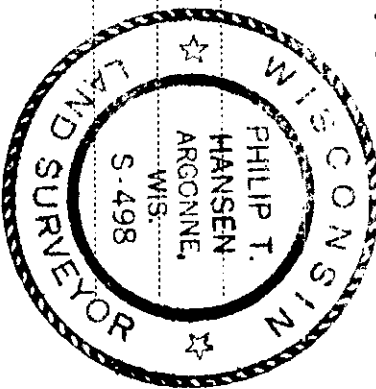

T36N R10E

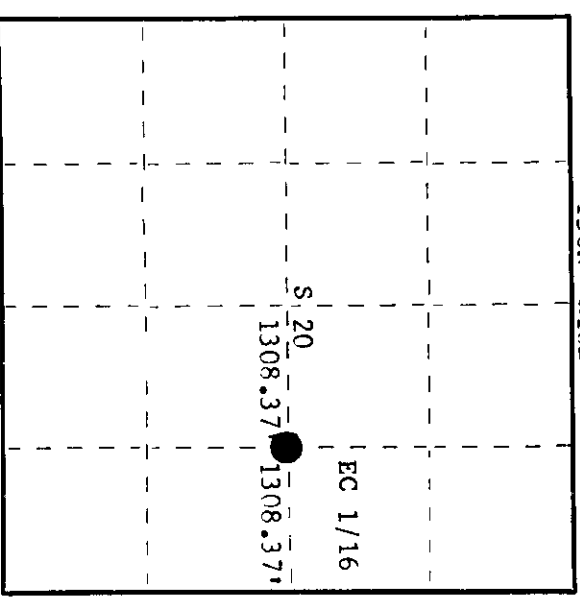

O = Corner monument restored.

Description of monument and accessories I established to perpetuate the original location of this corner.
Set 1 1/2" iron pipe with 2" brass cap, projecting 4' above ground, cap stamped:
Marked NBT's -
Black Spruce 6" S63°E 78.0 feet, scribed 1/16 BT
Black Spruce 6" S32°E 103.9 feet, scribed 1/16 BT

S498
T36N R10E
EC 1/16 S + 20
CPI-1979

Dated at Rhineland, Wis., this 8th day of May, 1979

Signature Phillip T. Hansen, Title Registered Land Surveyor, Registration No. S-498
County Surveyor, Registered Land Surveyor, or other duly authorized official

Office of Register of Deeds, County of Oneida, I hereby certify that the within
instrument was filed in this office for record on the 14th day of May, 1979
at 3:30 o'clock P.M.

Doris Savage Fisher
(Register of Deeds)

By: _____ Deputy

3610202010