

CERTIFIED LAND CORNER RESTORATION



Index No. 07

State of Wisconsin

County of Oneida } ss.

I Phillip T. Hansen, do hereby certify that on the 3rd day of March, 19 79, I ~~found~~ restored the NC 1/16 corner of Section 20 Township 36, North, Range 10 East, Fourth Principal Meridian, as described hereon; and that from this evidence I established a new monument and accessories as described hereon to perpetuate the original location of this corner.

Resident witnesses:  
Glen Barker  
Jim Claffin  
Herb Wagoner

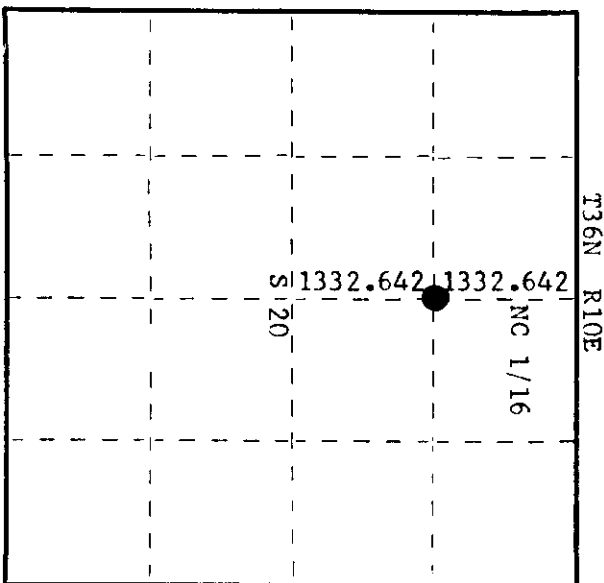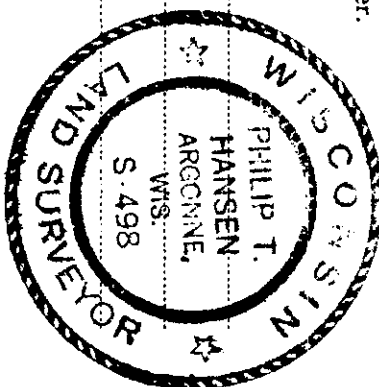

○ = Corner monument restored.

History of original corner establishment:  
No records of any previous survey

Description of corner evidence found:  
No evidence of any corner recovered. Corner established by traverse and computation. C 1/4 corner established at point 2665.284' S 0° 21' 39" W of N 1/4 corner. Set the NC 1/16 corner at 1332.642' intermediate.

Description of monument and accessories I established to perpetuate the original location of this corner.  
Set 1-1/2" iron pipe with 2" brass cap, projecting 24" above ground, stamped:  
Marked NBT's -  
Jack Fine 10" N 3° E, 34.60' scribed 1/16 BT.  
Jack Fine 10" N39° E, 72.50' scribed 1/16 BT.

S498  
T36N R10E  
NC 1/16 S 20  
CFI-1979

Dated at Rhineland, Wis., this 8th day of May, 19 79

Signature Phillip T. Hansen Title Registered Land Surveyor Registration No. S-498  
(County Surveyor, Registered Land Surveyor, or other duly authorized official)

Office of Register of Deeds, County of Oneida  
at 1:30 o'clock P. M. I hereby certify that the within instrument was filed in this office for record on the 14th day of May, 19 79

Doree Verage Kuhn  
(Register of Deeds)

By: \_\_\_\_\_ Deputy

3610203020

