

CERTIFIED LAND CORNER RESTORATION

Index No. **Q-13**

State of Wisconsin


County of Oneida } ss.

I Phillip T. Hansen, do hereby certify that on the 18th day of May, 1976, I found evidence of the S 1/16 corner of section 21 and 22 Township 36 North, Range 10 East, Fourth Principal Meridian,


as described hereon; and that from this evidence I established a new monument and accessories as described hereon to perpetuate the original location of this corner.

Resident witnesses:

- Glen Barker
- Jim Clarlin
- Herb Wagoner

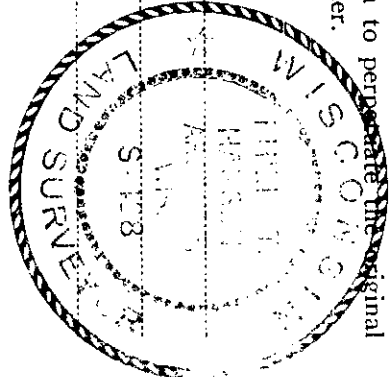

T36N R10E

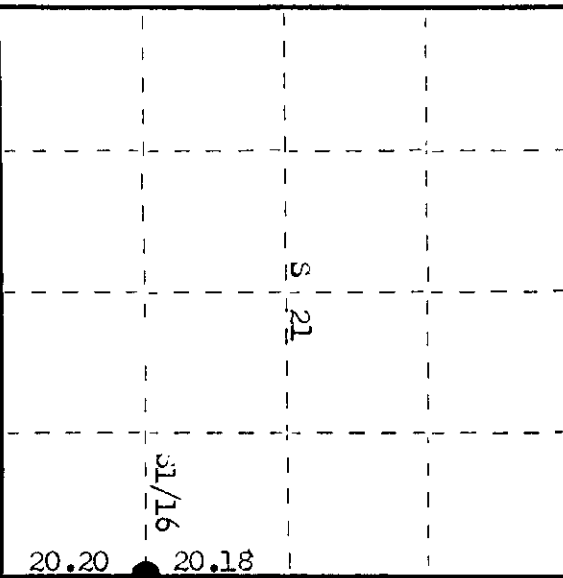

○ = Corner monument restored.

History of original corner establishment: Original Corner established by D.H. Vaughan, County Surveyor, in 1916. Marked MBTs - Cedar 10" S 83° E 25 1/2 lks, Cedar 10" S 83° W 9 1/2 lks. Corner recovered by H.C. Lawrence, registered Land Surveyor, in 1946. Recovered Vaughan's old post and stumps of his cedar BTs with scribe marks plain. Set new cedar post and marked MBT - Cedar 10" N 19° W 16 lks.

Description of corner evidence found: Recovered Lawrence's cedar post, squared and scribed S 21, S 1/16 S 22 in poor condition.
 Recovered Vaughan's old BTs - Cedar Stump 10" S 83° E 25.5 lks.
 Cedar stump 10" S 83° W 9.5 lks, scribed 1/8 S BT.
 Recovered Lawrence's BT - Cedar 10" (14") N 19° W 16 lks, scribed S 1/16 BT.

Description of monument and accessories I established to perpetuate the original location of this corner.
 Replaced 4" cedar post with 1 1/2" iron pipe with 2" brass cap stamped.
 Pipe projects 18" above ground.
 Marked MBT - Cedar 3" S 65° W 12.1 lks, scribed 1/16 BT.
 Monument and BTs painted blue.

3498
 T36N R10E
 S 21 S 22
 S 1/16
 GPL-1976

Dated at Rhinelander, Wis, this 3rd day of August, 1976

Signature *Phillip T. Hansen* Title Registered Land Surveyor Registration No. 5-498
 (County Surveyor, Registered Land Surveyor, or other duly authorized official)

Office of Register of Deeds, County of Oneida Grand day of September, 1976
 at 1:00 o'clock P.M. I hereby certify that the within instrument was filed in this office for record on the

Dona Verage Fuchse
 (Register of Deeds)

By Deputy

3610211000