

CERTIFIED LAND CORNER RESTORATION


Index No. **R-17**

State of Wisconsin }
 County of Oneida } ss.


I Phillip T. Hansen, do hereby
 certify that on the 20th day
 of May, 1976, I found
 evidence of the Section
 corner of S22, 23, 26, 27
 Township 36, North, Range
10 East, Fourth Principal Meridian,
 as described hereon; and that from this evidence
 I established a new monument and accessories
 as described hereon to perpetuate the original
 location of this corner.

Resident witnesses:

Glen Barker
Jim Claflin
Herb Wagoner

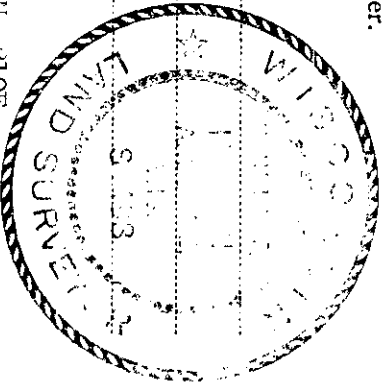

T36N R10E

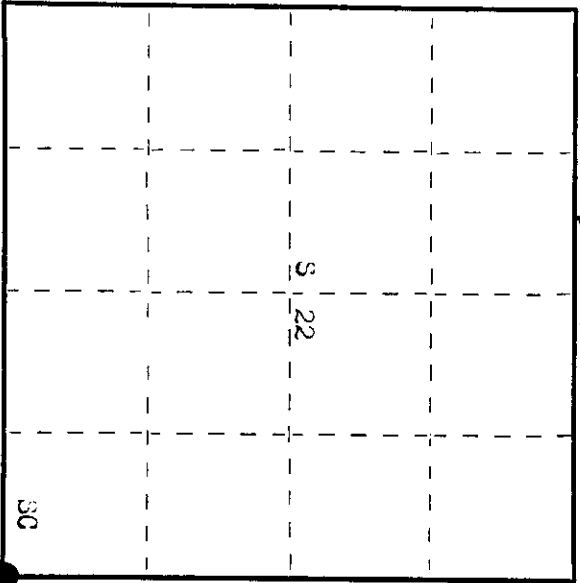

○ = Corner monument restored.

History of original corner establishment: Original Corner established by Wm. E. Dougherty, Deputy Surveyor, in 1863, from which Birch 10" bears N 74° E 40 lks, and tamarack 10" bears S 23° N 11 lks.
 Corner established by D.H. Vaughan, County Surveyor, re-established corner in 1910 from original BTs.

Corner recovered by H.C. Lawrence, Registered Land Surveyor, in 1947. Set new post and marked B.O. Telephone pole #1434.5 S 52° E 83 lks, and telephone pole 1435 S 48° N 105 lks.

Description of corner evidence found:

Recovered 4" tamarack post, squared and scribed S22, S23, S26, S27. Post was in very poor condition.

Recovered B.O. Telephone pole 1434.5 S 52° E 83 lks, has been cut off 2' above ground. Telephone pole 1435 S 48° N 105 lks, has been cut off 2' above ground.

Description of monument and accessories I established to perpetuate the original location of this corner.
 Replaced tamarack post with Bernsten #1 Federal Monument stamped.

Monument projects 24" above ground.

BT - Black spruce 6" S63° E 37.5 lks, scribed JC BT.

B.O. NE corner top cement culvert D&M, Mt,

S 43° W 183.1 lks.

Monument and BT painted blue.

T36N R10E
 sec. 22 | 23
27 | 26
 S498-1976

361022000


Signature: Phillip T. Hansen Title Registered Land Surveyor Registration No. S-498
 County Surveyor, Registered Land Surveyor, or other duly authorized official

Office of Register of Deeds, County of Oneida
 Instrument was filed in this office for record on the 20th day of September, 1976
 at 10 o'clock P. M.

Doris Verage Fiehn
 (Register of Deeds)

By: _____ Deputy