

CERTIFIED LAND CORNER RESTORATION

Index No. D-17



State of Wisconsin

County of Oneida } ss.

I Phillip T. Hansen, do hereby certify that on the 20th day of May, 1976, I found evidence of the Quarter corner of Sections 22 and 23 Township 36, North, Range 10 East, Fourth Principal Meridian, as described hereon; and that from this evidence I established a new monument and accessories as described hereon to perpetuate the original location of this corner.

Resident witnesses:

- Glen Barker
- Jim Claflin
- Herb Wagoner

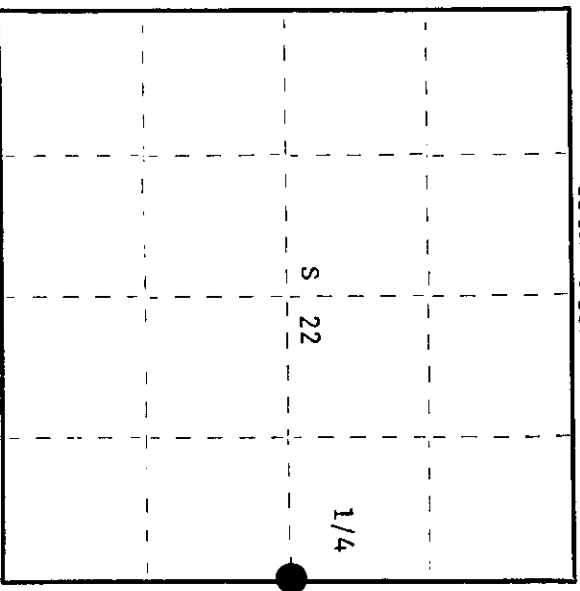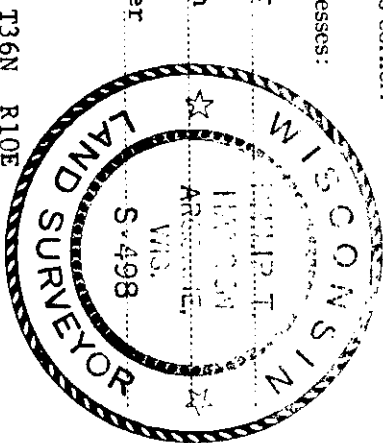

History of original corner establishment:  
 Original corner established by Wm. E. Dougherty, deputy surveyor, in 1863, from which Birch 10" bears N38°W 13 links and W.Pine 12" bears S49°E 18 links.  
 Corner re-established by D.H. Vaughan, county surveyor, in 1906. Set new post and marked NBT's - tamarack 10" N39°E 1 link  
 tamarack 10" S45°W 33 links  
 Corner recovered by H.C. Lawrence, Registered Land Surveyor, in 1947. Set an iron pipe with cap. Recovered old post and Vaughan's BT's.

Description of corner evidence found:  
 Recovered iron pipe in good condition. Also found Vaughan's old post beside it buried in moss and muck.  
 Recovered OBT's - tamarack 10" N39°E 1 link, now a decayed stump.  
 tamarack 10" S45°W 33 links, now a decayed stump, 1/4S scribing visible.

Description of monument and accessories I established to perpetuate the original location of this corner.  
 As the iron pipe was recovered in good condition, it was left in place.

- Added stamping to cap as follows:  
 Marked NBT's - w. pine 12" S14°W 33.8 links, scribed 1/4 BT. S498  
 b. spruce 7" N32°W 38.4 links, scribed 1/4 BT. T36N R10E  
 b. spruce 6" N83°W 50 links, scribed 1/4 BT. 22 1/4 23  
CPI-1976

Dated at Rhinelander, Wis., this 14th day of January, 1980

Signature Phillip T. Hansen Title Registered Land Surveyor Registration No. S-498  
 (County Surveyor, Registered Land Surveyor, or other duly authorized official)  
 Office of Register of Deeds, County of Oneida  
 Instrument was filed in this office for record on the 11th day of February, 1980  
 at 2:15 o'clock P. M.

Louis George Fuchs  
 (Register of Deeds)

By: \_\_\_\_\_ Deputy

3610222000

○ = Corner monument restored.