

CERTIFIED LAND CORNER RESTORATION

Index No. P-14

State of Wisconsin

County of Oneida } ss.



I Phillip T. Hansen, do hereby certify that on the 19th day of May, 1976, I found evidence of the WC 1/16 corner of Section 22 Township 36, North, Range 10 East, Fourth Principal Meridian, as described hereon; and that from this evidence I established a new monument and accessories as described hereon to perpetuate the original location of this corner.

Resident witnesses:

Glen Barker

Jim Claflin

Herb Wagoner

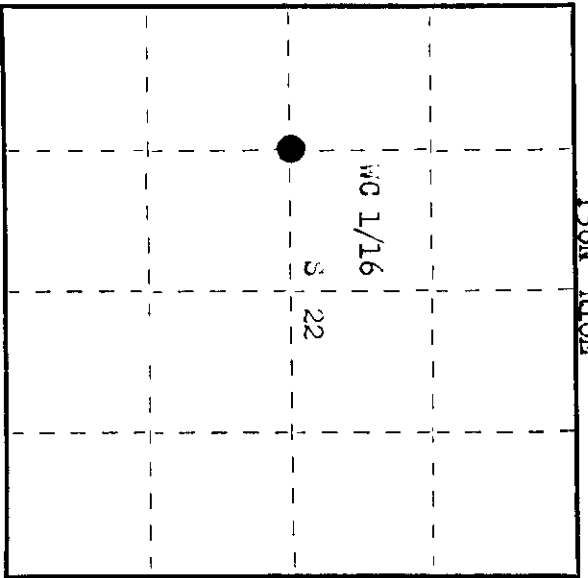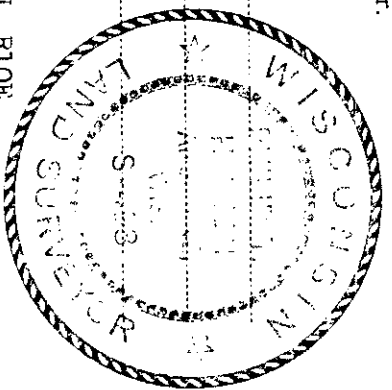

○ = Corner monument restored.

History of original corner establishment:
Original Corner established by B.H. Vaughan, County Surveyor, in 1910.

Corner recovered by H.C. Lawrence, Registered Land Surveyor, in 1947. Set new post and marked NBTs - N. Birch 7" N 30° S 17 lks, N. Birch 9" S 20° W 51½ lks.

Description of corner evidence found:

Recovered 6" squared cedar post, scribed WC 1/16 S22, in fair condition.

Recovered NBTs - N. Birch 7" N 30° E 17 lks, pushed over with dozer.
N. Birch 9" S 20° W 51.5 lks, pushed over with dozer.

This area has been logged off.

Description of monument and accessories I established to perpetuate the original location of this corner.
Replaced 6" cedar post with 1½" iron pipe with 2" brass cap stamped.
Monument projects 18" above ground.
Built a rock cairn around base of monument.

NBTs - Maple 8" N 66° E 51 lks, scribed 1/16 BT.
Red Oak 6" S 40° W 86 lks, scribed 1/16 BT.
WC 1/16 S 22
T36N R10E
S498
CPL-1976

Dated at Rhineland, Wis., this 4th day of August, 1976.

Signature: Phillip T. Hansen Title: Registered Land Surveyor Registration No. S-498
County Surveyor, Registered Land Surveyor, or other duly authorized official

Office of Register of Deeds, County of Oneida. I hereby certify that the within instrument was filed in this office for record on the 22nd day of September, 1976 at 10:00 o'clock P. M.

Dorcas Verage Fiehn
(Register of Deeds)

By: _____ Deputy

3610222030