

CERTIFIED LAND CORNER RESTORATION

Index No. **R-18**

State of Wisconsin

County of **Oneida** } ss.



I **Phillip T. Hansen** do hereby certify that on the **5th** day of **January** 19**77**, I found evidence of the **W 1/16** corner of **Section 23 & 26** Township **36** North, Range **10 East**, Fourth Principal Meridian, as described hereon; and that from this evidence I established a new monument and accessories as described hereon to perpetuate the original location of this corner.

Resident witnesses:

Glen Barker

Jim Clarlin

Herb Wagoner

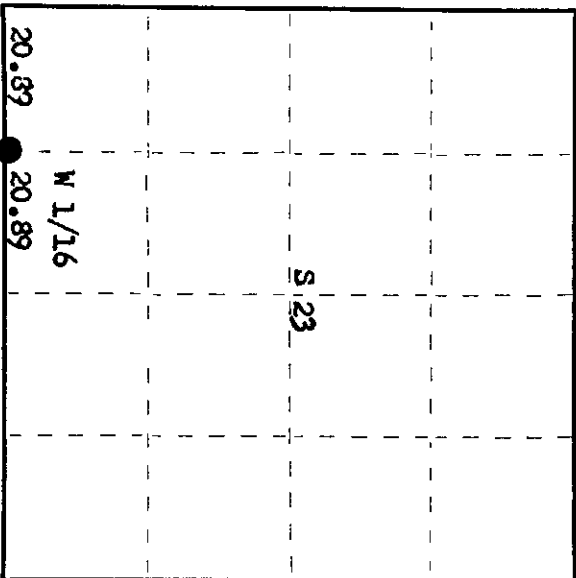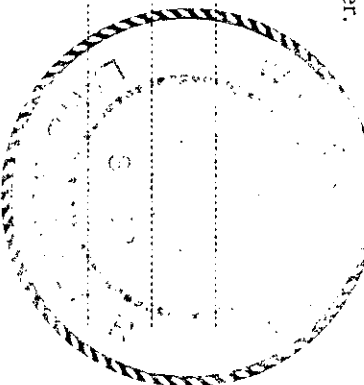

○ = Corner monument restored.

History of original corner establishment:

Corner established by D.H. Vaughan, County Surveyor, in 1910. Set post and marked BTs - Tamarack 12" N 61 1/2° W 47 links and Tamarack 12" S 35° E 41 1/4 links. H.C. Lawrence, Registered Land Surveyor, recovered Vaughan's post which had been burned off even with the ground. Also recovered Vaughan's BTs. He set new post in old post hole and rescribed the tamarack stump of Vaughan's BTs. A large boulder 6' base and 2' high bears S 50° W 87 1/2 links.

Description of corner evidence found:

Recovered Lawrence's tamarack point 2 ft. long with rock cairn around it.
Recovered Vaughan's tamarack stump 22" S 35° E 41 1/4 links, now very decayed.

Description of monument and accessories I established to perpetuate the original location of this corner.

Replaced Lawrence's post with 1 1/2" iron pipe with 2" brass cap stamped:
Monument projects 18" above ground. S498
T36N R10E
NBRTs - Black Spruce 8" N 85° W 94.6 links, scribed 1/16 BT. W 1/16 S 1 23
White Spruce 10" N 34° W 62.7 links, scribed 1/16 BT. S 1 26
CPI-1977
Corner is 2 chains north of Bug Lake Creek.

Dated at **Rhineland**, Wis., this **19th** day of **January**, 19**77**

Signature: *Phillip T. Hansen* Title: **Registered Land Surveyor** Registration No. **S-498**
(County Surveyor, Registered Land Surveyor, or other duly authorized official)

Office of Register of Deeds, County of **Oneida**
Instrument was filed in this office for record on the **24th** day of **February**, 19**77**
at **1:00** o'clock **P.**M.

Doris Verage Kuehn
(Register of Deeds)

By: _____ Deputy

3610230030