



CERTIFIED LAND CORNER RESTORATION

Index No. **Q-21**

State of Wisconsin }
 County of Oneida } ss.

I Phillip T. Hansen, do hereby
 certify that on the 4th day
 of January, 1977, I found
 evidence of the S 1/16
 corner of Section 23 & 24
 Township 36, North, Range
10 East, Fourth Principal Meridian,
 as described hereon; and that from this evidence
 I established a new monument and accessories
 as described hereon to perpetuate the original
 location of this corner.

Resident witnesses:
Glen Barker
Jim Clafflin
Herb Wagoner

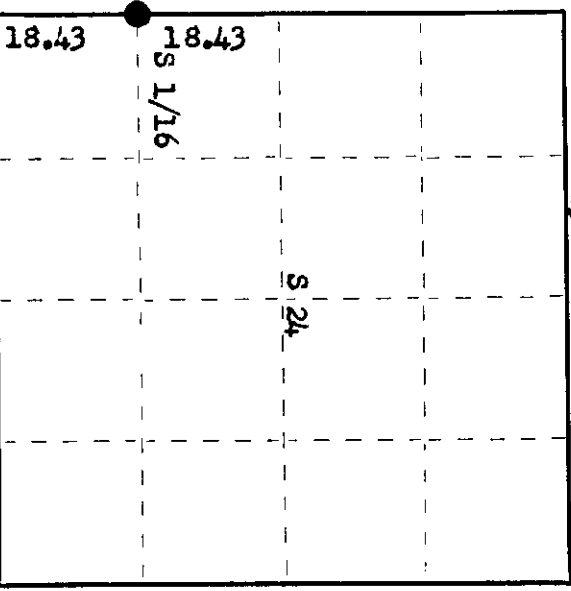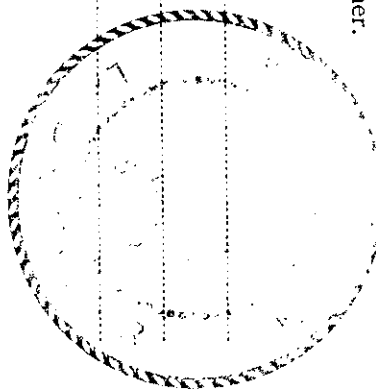

○ = Corner monument restored.

History of original corner establishment:

Corner originally established by D.H. Vaughan, County Surveyor. Set wood post but did not mark any Bts.
 Corner re-established by H.C. Lawrence, Registered Land Surveyor, in 1947. Ran a random line S 4° E from re-established 1/4 corner, 36.86 chains, to close out 5.45 chains west of Section Corner at right angles. Corrected bearing S 12° 17' E. Set 1/16 post at 18.43 chains, 2.72½ chains east. Piled a large rock cairn around base of monument.

Description of corner evidence found:

Recovered Lawrence's 3" pine post, squared and scribed S 1/16 S24 in very poor condition. Found rock cairn around base of the post. No Bts were recovered.

Description of monument and accessories I established to perpetuate the original location of this corner.

Replaced 3" pine post with 1½" OD iron pipe with 2" brass cap stamped:
 Monument projects 18" above ground.
 NBT - White Birch 8" N 40° W 70 links, scribed 1/16 BT.
 No other trees suitable for BT.
 Replaced rock cairn around base of monument.
 An old E-W swamp road is 40 links north of Corner.

S498
 T36N R10E
 S23 | S24
 S 1/16
 CPI-1977

3610231000

Dated at Rhineland, Wis., this 19th day of January, 1977.

Signature Phillip T. Hansen Title Registered Land Surveyor Registration No. S-498
 (County Surveyor, Registered Land Surveyor, or other duly authorized official)

Office of Register of Deeds, County of Oneida. I hereby certify that the within instrument was filed in this office for record on the 24th day of February, 1977 at 1:00 o'clock P. M.

Doree Verage Kuehn
 (Register of Deeds)

By: _____ Deputy