

CERTIFIED LAND CORNER RESTORATION

Index No. **Q-19**

State of Wisconsin } ss.

County of Oneida

I, Phillip T. Hansen, do hereby



certify that on the 18th day of July, 1975, I found

evidence of the SC-1/16 corner of Section 23

Township 36, North, Range 10 East, Fourth Principal Meridian,

as described hereon; and that from this evidence I established a new monument and accessories as described hereon to perpetuate the original location of this corner.

Resident witnesses:

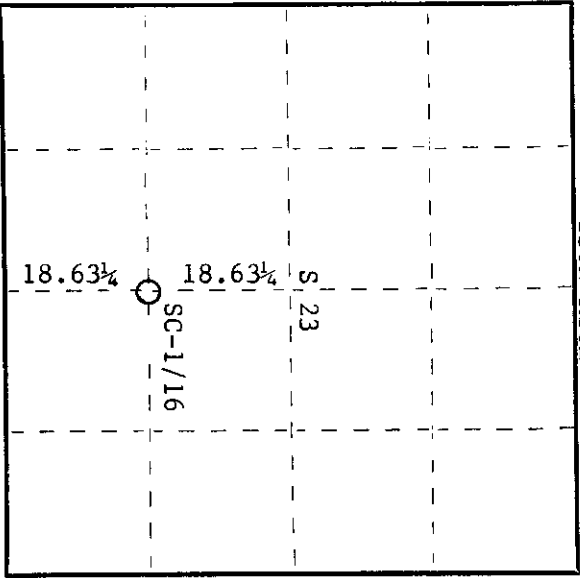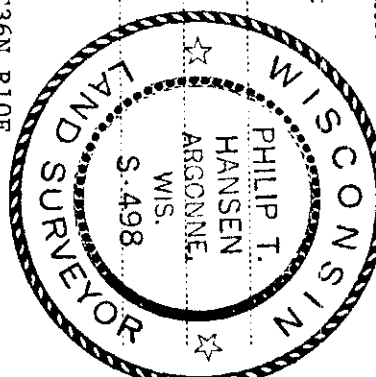

O = Corner monument restored.

History of original corner establishment:

Original corner established by D.H. Vaughan, County Surveyor, in 1910, from which white pine 26" bears N3-1/2°E, 31 links, and white pine 24" bears S15°W, 34/2 links.

Recovered by H.C. Lawrence, Registered Land Surveyor, in 1948. Set new oak stake from which hemlock 14" bears N43°E, 48 links, and hemlock 8" bears S51°W, 50 links.

Description of corner evidence found:

Recovered 3" oak post, squared and scribed SC-1/16, S23 in poor condition.

Recovered OBT's - White pine 26" N3-1/2°E 31 links - now decayed stump.

White pine 24" S15°W 31-1/2 links - now decayed stump.

Hemlock 14" N43°E 48 links - now a stump scribed NBT.

Hemlock 8" S51°W 50 links - stump scribed NBT.

Hemlock 14" S47°W 69 links - now a cut-off stump.

Description of monument and accessories I established to perpetuate the original location of this corner.

Replaced 3" oak with 1-1/2" iron pipe with 2" brass cap stamped -

NBT's - White birch 9" S41°W 18.7 links - scribed S498  
1/16 BT. T36N R10E

Red maple 6" S73°E 42 links - scribed S 23  
1/16 BT. SC-1/16

CPI-1975

Dated at Rhineland, Wis., this 29th day of July, 1975

Signature Phillip T. Hansen Title Registered Land Surveyor Registration No. S-498  
(County Surveyor, Registered Land Surveyor, or other duly authorized official)

Office of Register of Deeds, County of Oneida together herewith that the within instrument was filed in this office for record on the 1st day of October, 1975 at 3:05 o'clock P. M.

Lois George Fisher  
(Register of Deeds)

By: \_\_\_\_\_ Deputy

3610231020