

CERTIFIED LAND CORNER RESTORATION

Index No. **Q-18**

State of Wisconsin

County of Oneida



} ss.

I Phillip T. Hansen, do hereby certify that on the 5th day of January, 1977, I found evidence of the SW 1/16 corner of Section 23 Township 36, North, Range 10 East, Fourth Principal Meridian,

as described hereon; and that from this evidence I established a new monument and accessories as described hereon to perpetuate the original location of this corner.

Resident witnesses:

- Glen Barker
- Jim Claflin
- Harb Wagoner

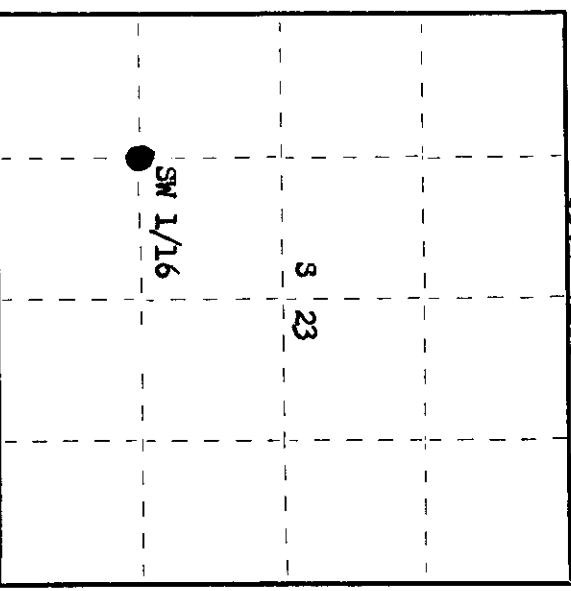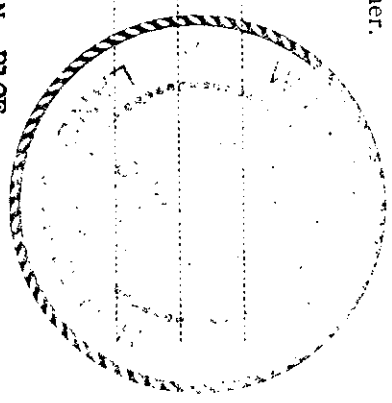

○ = Corner monument restored.

History of original corner establishment:

Original Corner established by D.H. Vaughan, County Surveyor, in 1910. Set a wood post and marked BTs - White Pine 28" N 67° E 54 links and White Pine 22" N 27° W 43 links. Corner recovered by H.C. Lawrence, Registered Land Surveyor, in 1947. He had recovered Vaughan's old post in 1945. Recovered Vaughan's BTs and set new post in 1947.

Description of corner evidence found:

Recovered Lawrence's 5" cedar post, squared and scribed SW 1/16 S23, SW 1/16 S23 in very poor condition.  
 Also recovered a part of Vaughan's post laying beside it.  
 Recovered OBTS - Vaughan's White Pine stump N 67° E 54 links, H.C. Lawrence had driven a cedar stake, scribed BT in center of stump.  
 White pine stump N 27° W 43 links, also has a cedar stake in center scribed BT.

Description of monument and accessories I established to perpetuate the original location of this corner.

Replaced 5" cedar post with 1 1/2" OD iron pipe with 2" brass cap stamped:  
 Monument projects 24" above ground. 3498  
 NBT - Cedar 8" N 15° W 42.2 links, scribed 1/16 BT. T36N R10E  
 Cedar 7" N 76° W 52.8 links, scribed 1/16 BT. SW 1/16 S 23  
CPI-1977

Dated at Rhinelander, Wis. this 20th day of January, 1977.

Signature Phillip T. Hansen Title Registered Land Surveyor Registration No. S-498  
 (County Surveyor, Registered Land Surveyor, or other duly authorized official)

Office of Register of Deeds, County of Oneida. I hereby certify that the within instrument was filed in this office for record on the 24th day of February, 1977 at 108 o'clock P. M.

Dorcas Verage Kuehler  
 (Register of Deeds)

By: \_\_\_\_\_ Deputy

3610231030