

CERTIFIED LAND CORNER RESTORATION



Index No. **P-21**

State of Wisconsin

County of Oneida } ss.

I Philip T. Hansen do hereby certify that on the 18th day of July, 1975 I found evidence of the Quarter corner of Sections 23 and 24 Township 36 North, Range 10 East, Fourth Principal Meridian, as described hereon; and that from this evidence I established a new monument and accessories as described hereon to perpetuate the original location of this corner.

Resident witnesses:

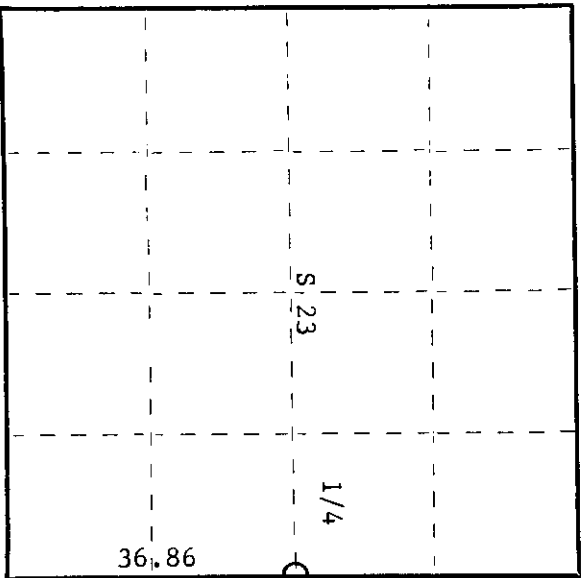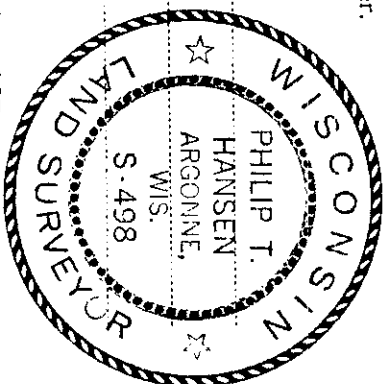

O = Corner monument restored.

CERTIFIED LAND CORNER RESTORATION

History of original corner establishment:

Original corner established by Wm. E. Dougherty, Government Deputy Surveyor, in 1863, from which birch 10" bears N37°W, 18 links, and pine 15" bears S49°E, 21 links.

D.H. Vaughan, County Surveyor, recovered the original BT and set new post and made new BT's - white pine stump 20" N4°W one link and white pine stump 12" S9°E 37 links.

H.C. Lawrence, Registered Land Surveyor, recovered white pine stumps and set new corner in 1947. Made new BT - twin white birch 10" N77°W 63-1/2 links.

Description of corner evidence found:

Recovered 6" cedar post, squared and scribed 1/4 S S23, 1/4 S S24 in fair condition.

Recovered OBT's - White pine stump 20" N4°W one link - badly decayed.

White pine stump 12" S9°E 37 links - decayed but can see some of

scribe marks Lawrence had placed on 2"x4" cedar stake in front of this stump, scribed BT.

Twin birch 10" N77°W 63.5 links - now a cut-off stump.

Description of monument and accessories I established to perpetuate the original location of this corner.

Replaced 6" cedar post with 2-1/2" iron pipe with brass cap stamped -

NBT's - Red maple 5" S41°W 12.4 links - scribed S498  
1/4 BT. T36N R10E

Sugar 5" N5°W 46 links - scribed S23 S24  
1/4 BT. 1/4

Corner is 67 links south of white post with location CPI-1975 poster on south side of CPI road.

Dated at Rhinelanders, Wis., this 30th day of July, 1975.

Signature: *Philip T. Hansen* Title Registered Land Surveyor Registration No. S-498  
County Surveyor, Registered Land Surveyor, or other duly authorized official

Office of Register of Deeds, County of Oneida I hereby certify that the within instrument was filed in this office for record on the 1st day of October, 1975 at 3:00 o'clock P.M.

*Thomas J. Kuehn*  
(Register of Deeds)

By: Deputy

3610232000