

CERTIFIED LAND CORNER RESTORATION

Index No. P-19

State of Wisconsin

County of Oneida

ss.

I Phillip T. Hansen

certify that on the 5th day

of January, 1977, I found

evidence of the C 1/4

corner of Section 23

Township 36

10 East, Fourth Principal Meridian,



as described hereon; and that from this evidence I established a new monument and accessories as described hereon to perpetuate the original location of this corner.

Resident witnesses:

Glen Barker

Jim Glavin

Herb Wagoner

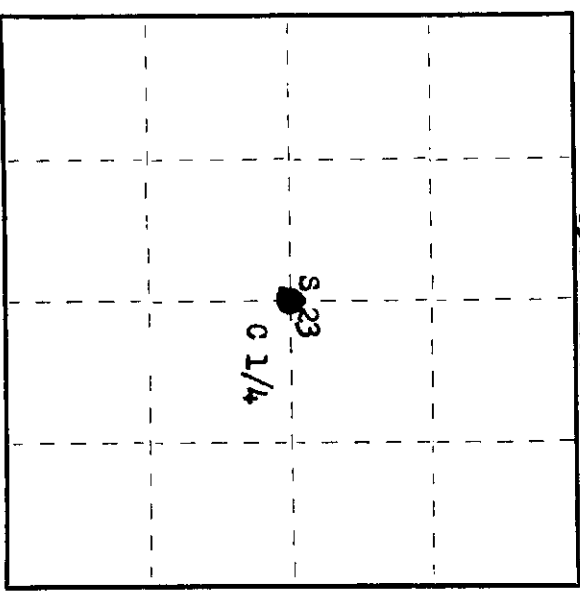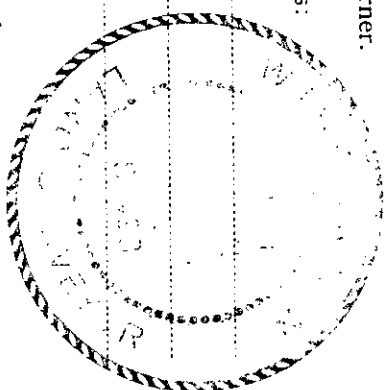

○ = Corner monument restored.

History of original corner establishment:

Original Corner established by D.H. Vaughan, County Surveyor, in 1906. Set post and marked BTs - White Pine N 61° W 7 links, White Pine S 37° W 27 1/2 links.

H.C. Lawrence, Registered Land Surveyor, recovered Vaughan's Corner in 1948. It was encircled with rocks in center of an old woods road. Recovered Vaughan's BTs which were rotten in center. Set scribed cedar plugs in center.

Description of corner evidence found:

Recovered Lawrence's 6" cedar post, squared and scribed C 1/4 S23, C 1/4 S23 with a rock cairn around base.

Also recovered the top portion of Vaughan's old post, scribing 1/4's still visible.

Recovered OBTs - White Pine stump N 61° W 7 links, now decayed.

White Pine stump S 37° W 27 1/2 links, old scribe marks 1/4's BT visible.

Description of monument and accessories I established to perpetuate the original location of this corner.

Replaced 6" cedar post with 2 1/2" Bernitsen A-1 Federal Monument, magnet installed in cap and base. Cap stamped:

Replaced rock cairn around base.

NBT - White Pine 20" S 53° E 2.465 chains, scribed C 1/4 BT.

Corner sets 1.5 chains west of Hay Meadow Creek Road.

Area has all been cut over, no additional trees suitable for BTs.

T36N R10E
C 1/4 S 23
S498-1977

Dated at Rhinelander, Wis., this 20th day of January, 1977.

Signature Phillip T. Hansen Title Registered Land Surveyor Registration No. S-498
(County Surveyor, Registered Land Surveyor, or other duly authorized official)

Office of Register of Deeds, County of Oneida
Instrument was filed in this office for record on the 24th day of February, 1977
at 1:00 o'clock P. M.

Dorice Verage Kuehn
(Register of Deeds)

By: _____ Deputy

3610232020