

CERTIFIED LAND CORNER RESTORATION

Index No. 0-21

State of Wisconsin



County of Oneida } ss.

I, Phillip T. Hansen, do hereby certify that on the 11th day of March, 1976, I found evidence of the N 1/16 corner of sec. 23 and 24, Township 36, North, Range 10 East, Fourth Principal Meridian, as described hereon; and that from this evidence I established a new monument and accessories as described hereon to perpetuate the original location of this corner.

Resident witnesses:

Glen Barker

Herb Wagoner

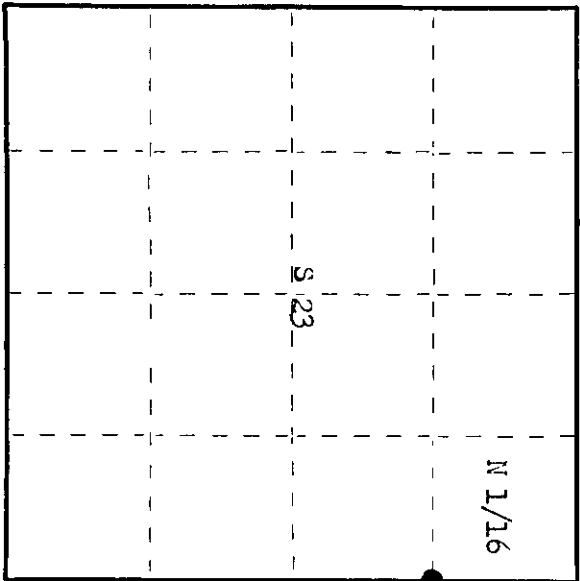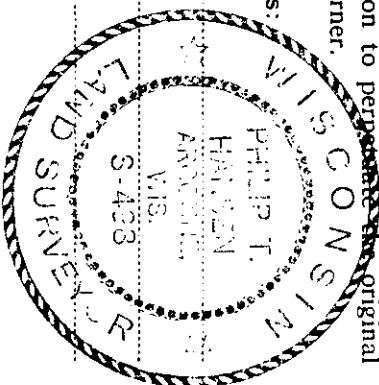

○ = Corner monument restored.

History of original corner establishment: Original corner established by D.H. Vaughan, H.C. Lawrence recovered URTS - Tamarack 16" N2 1/2° 35 lks and Tamarack 12" N30° 20 lks. Set new post and marked NRTS - Balsam 8" N30°, 26 lks and Maple 3" N8°, 32 1/2 lks.

Description of corner evidence found: Recovered Lawrence's 4" cedar post, squared and scribed N 1/16 S23, N 1/16 S24 in fair condition.

This area had been logged, clear cut, so there was no evidence of RTs.

Description of monument and accessories I established to perpetuate the original location of this corner.

Replace 4" cedar post with 1 1/2" iron pipe with 2" brass cap stamped.

Pipe projects 30" above ground.

NRT - Maple 6" N20° 37 lks, scribed 1/16 RT.

N.M. 3/4" iron pipe w/2" brass cap west 40 lks.

N.M. stamped - W/C 40 lks.

Corner monument, RT and N.M. painted blue.

S498
T36N R10E
S23/S24
N 1/16
CRI-1976

Dated at Rhineland, Wis., this 21st day of May, 1976

Signature Phillip T. Hansen Title Registered Land Surveyor Registration No. 2498
(County Surveyor, Registered Land Surveyor, or other duly authorized official)

Office of Register of Deeds, County of Oneida, I hereby certify that the within instrument was filed in this office for record on the 16th day of May, 1976 at 2:00 o'clock P. M.

Robert L. H. H. H.
(Register of Deeds)

By: _____ Deputy

3610233000

