

CERTIFIED LAND CORNER RESTORATION

Index No. **Q-19**



State of Wisconsin } ss.  
 County of Oneida }

I Philip T. Hansen, do hereby  
 certify that on the 22nd day  
 of July 1975, I found  
 evidence of the NC-1/16  
 corner of Section 23  
 Township 36 North, Range  
 10 East, Fourth Principal Meridian,

as described hereon; and that from this evidence  
 I established a new monument and accessories  
 as described hereon to perpetuate the original  
 location of this corner.

Resident witnesses:

Glen Barker  
 Jim Garlin

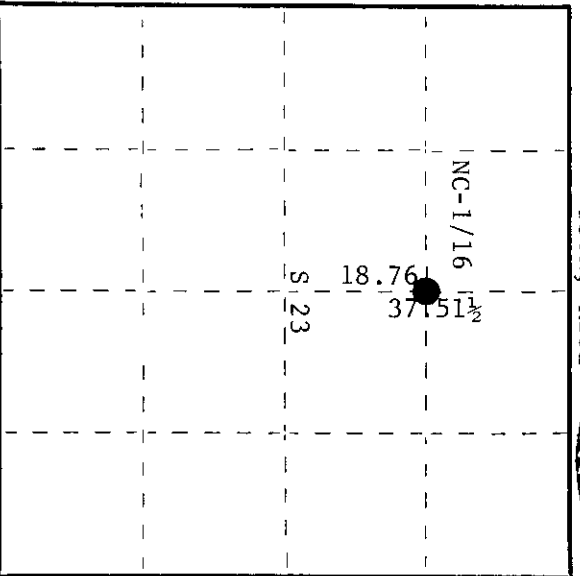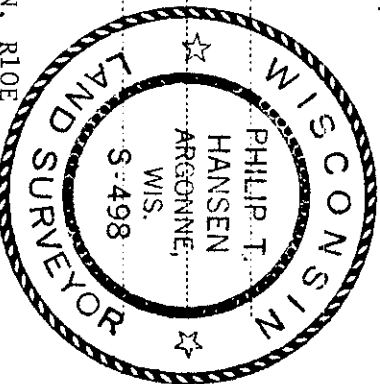

○ = Corner monument restored.

History of original corner establishment: Corner established by D.H. Vaughan, County Surveyor, in 1910 from which white pine 16" bears N49°E, 15½ links and tamarack 14" bears S20°W, 33½ links. Corner recovered by H.C. Lawrence, Registered Land Surveyor. He ran a random line North 7°50'E var. from the C-1/4 corner and at 18.76 chains was 6 links West of Vaughan's NC-1/16 corner. Recovered both of Vaughan's pine stumps at designated bearings and distance. Also, recovered someone's marked hemlock 16" bearing N63°W, 35½ links, standing green. Set new post and marked NBT maple 14", S15°W, 18 links.

Description of corner evidence found:  
 Recovered Lawrence's 4" cedar post, squared and scribed NC-1/16 S23, in fair condition.  
 Recovered OBT white pine stump, N47°E (N50°E), 16.5 links. Lawrence had set a 3" squared post, scribed BT, in the center of this stump.  
 Recovered - Red maple 14" (16") S15°W 18.0 links - scribed NC-1/16 S23 NBT Hemlock 16" (18") N63°W 35.5 links - top scribing grown over bottom NBT

Description of monument and accessories I established to perpetuate the original location of this corner.  
 Replaced 4" cedar post with 1½" OD iron pipe with 2" brass cap stamped - S498  
 No additional accessories established. T36N, R10E  
 NC-1/16 S 23  
 CPI-1975

Dated at Rhineland, Wis., this 31st day of July, 1975.

Signature: *Philip T. Hansen* Title: Registered Land Surveyor Registration No. S-498  
 (County Surveyor, Registered Land Surveyor, or other duly authorized official)

Office of Register of Deeds, County of Oneida, at 2:02 o'clock P.M. 14th day of October 1975

*Donna Savage Kuehn*  
 (Register of Deeds)

By: Deputy

3610233020