

CERTIFIED LAND CORNER RESTORATION

Index No. R-23

State of Wisconsin

County of Oneida

} ss.

I Phillip T. Hansen, do hereby certify that on the 28th day of December, 19 76, I found evidence of the Quarter corner of Section 24 & 25 Township 36, North, Range 10 East, Fourth Principal Meridian,


as described hereon; and that from this evidence I established a new monument and accessories as described hereon to perpetuate the original location of this corner.

Resident witnesses:


Glen Barker

Jim Clarlin

Herb Wagoner

 

T36N R10E

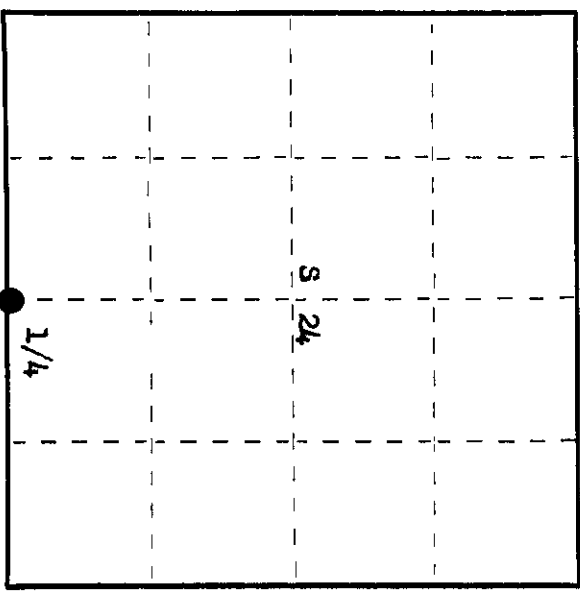

○ = Corner monument restored.

History of original corner establishment:

Original Corner established by Wm. E. Dougherty, Deputy Surveyor, in 1863, from which Ash 8" bears N 10° W 10 links and Ash 15" bears S 21° E 47 links. Corner recovered by D.H. Vaughan, County Surveyor, in 1910. Found the original BTs and set new post. Corner recovered by H.C. Lawrence, Registered Land Surveyor, in 1947. Set new post, but no record of any NBTs.

Description of corner evidence found:

Recovered old 3" squared cedar post, still standing, no scribbing visible. Also recovered a 2 1/2" iron pipe, with brass cap, untamped, lying beside it. No evidence of the original BTs or any subsequent BTs.

Description of monument and accessories I established to perpetuate the original location of this corner.

Replaced old post with 2 1/2" Bernitsen A-1 Federal Monument, stamped:  
Monument projects 24" above ground.  
NBTs - Maple 7" N 32° E 49.3 links  
Cedar 9" S 19° E 84.2 links  
Cedar 7" S 35° W 62 links, all scribbed 1/4 BT.  
Corner sets south 60 links from Bug Lake Creek.

T36N R10E  
1/4 S 24  
S 25  
S498-1976

Dated at Rhineland, Wis., this 19th day of January, 1977.

Signature Phillip T. Hansen Title Registered Land Surveyor Registration No. S-498  
(County Surveyor, Registered Land Surveyor, or other duly authorized official)

Office of Register of Deeds, County of Oneida  
Instrument was filed in this office for record on the 24th day of January, 1977  
at 1:08 o'clock P. M.

Doris Verage Kuehn  
(Register of Deeds)

By \_\_\_\_\_ Deputy

3610240020



---

done in the 70's. Made new B.T.'s and set plastic sign post bearing North 1.0'.

REGISTER OF DEEDS OFFICE  
ONEIDA COUNTY, WIS.  
**FILED**  
OCT 29 1999  
At \_\_\_\_\_ O'Clock \_\_\_\_\_ M  
THOMAS H. LEIGHTON  
REGISTER OF DEEDS