

CERTIFIED LAND CORNER RESTORATION

Index No. **Q-1**

State of Wisconsin

County of Oneida

ss.

I Phillip T. Hansen

, do hereby

certify that on the 10th day of December, 1976, I found

evidence of the S 1/16

corner of Section 19 & 24

Township 36, North, Range

10 & 11 East, Fourth Principal Meridian,



as described hereon; and that from this evidence I established a new monument and accessories as described hereon to perpetuate the original location of this corner.

Resident witnesses:

Glen Barker

Jim Claflin

Herb Wagoner

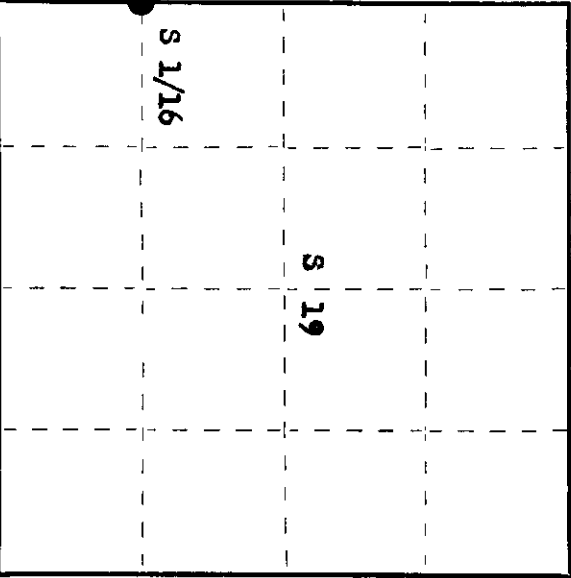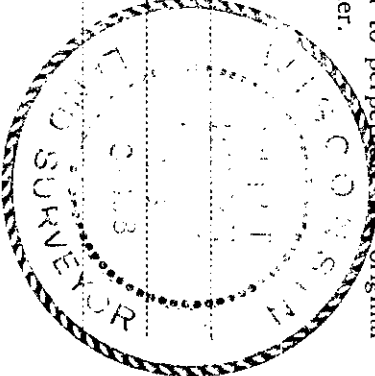

History of original corner establishment:  
 Corner established by D.H. Vaughan, County Surveyor, in 1904. Set post and marked BTs - Cedar 10' N 56° E 22 links and Cedar 10' S 63° W 26 links.  
 Corner post and both BTs recovered by H.C. Lawrence, Registered Land Surveyor, in 1947.  
 Set new post.

Description of corner evidence found:

Recovered Lawrence's 3" cedar post, squared and scribed S 1/16 T36N S19 R11E, 24 R10E in poor condition. Also recovered a piece of Vaughan's old post with the point still intact in the muck.  
 Recovered OBT - Cedar 10' S 63° W 22 links, our distance 31.5 links. This is now a 3' stub scribed BT.  
 Could not see any evidence of corner having been moved.

Description of monument and accessories I established to perpetuate the original location of this corner.

Replaced point of old post with 1 1/2" OD iron pipe with brass cap stamped:  
 Monument projects 12" above ground.  
 NBT - Cedar 10' S 68° E 29.7 links  
 Cedar 7' N 35° E 62.2 links, scribed 1/16 BT.  
 Drove support stakes beside new monument.

S4,98  
 R T36N R  
 10 24 19 11  
 E  
 CPI-1976

Dated at Rhineland, Wis., this 15th day of December, 1976

Signature Phillip T. Hansen Title Registered Land Surveyor Registration No. S-498  
 (County Surveyor, Registered Land Surveyor, or other duly authorized official)

Office of Register of Deeds, County of Oneida  
 Instrument was filed in this office for record on the 7th day of February, 1977  
 at 1:45 o'clock P. M.

Barbara Tenager Fiedler  
 (Register of Deeds)

By Joseph M. Bonner Deputy

0001019M