

CERTIFIED LAND CORNER RESTORATION

Index No. P-23

State of Wisconsin

County of Oneida

ss.

I Phillip T. Hansen

, do hereby

certify that on the 28th day

of December, 1976, I found

evidence of the C 1/4

corner of Section 24

Township 36

10 East, Fourth Principal Meridian,


as described hereon; and that from this evidence I established a new monument and accessories as described hereon to perpetuate the original location of this corner.

Resident witnesses:


Glen Barker

Jim Clarlin

Herb Wagoner

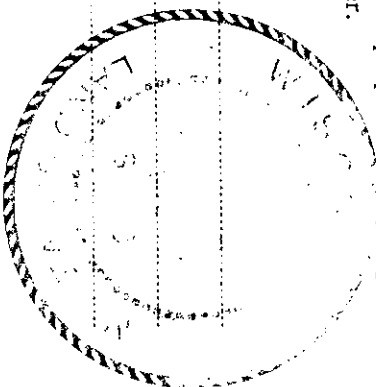

T36N R10E

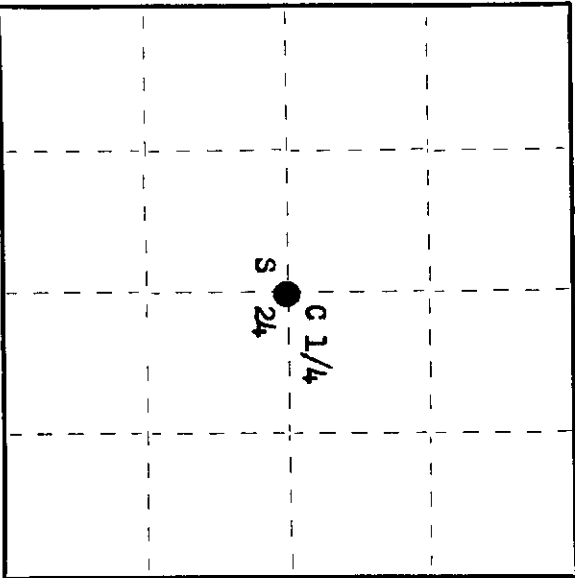

○ = Corner monument restored.

History of original corner establishment:

Corner established by D.H. Vaughan, County Surveyor, in 1910. Set wood post and marked NBTs - Cedar 10" N 16° E 8-3/4 links and Cedar 10" S 20° W 17 links.

Corner recovered by H.C. Lawrence, Registered Land Surveyor, in 1947. Recovered Vaughan's cedar BTs and set new post.

Description of corner evidence found:

Recovered a piece of Vaughan's old post lying under snow on ground.

Recovered Vaughan's OBTs - Cedar 10" (12") S 20° W 17 links, scribing no longer visible.

Cedar 10" N 16° E 8-3/4 links, now blown down and rotted.  
Cedar 14" N 60° W (N 57° W) 21 links, scribed C 1/4 S24 NBT.

Description of monument and accessories I established to perpetuate the original location of this corner.

From recovered BTs, intersected cross ties to determine location. Set 2 1/2" Bernitsen A-1 Federal Monument with magnet in cap and base. Cap stamped:

NBTs - Cedar 10" S 25° E 29.4 links, scribed C 1/4 BT.  
Cedar 6" S 68° W 26.7 links, scribed C 1/4 BT.

T36N R10E  
S 1/4 S 24  
S498-1976

Dated at Rhineland, Wis., this 19th day of January, 1977

Signature Phillip T. Hansen Title Registered Land Surveyor Registration No. S-498  
(County Surveyor, Registered Land Surveyor, or other duly authorized official)

Office of Register of Deeds, County of Oneida. I hereby certify that the within instrument was filed in this office for record on the 24th day of February, 1977 at 1:00 o'clock P. M.

Dorcas Berge Kuehn  
(Register of Deeds)

By: \_\_\_\_\_ Deputy

3610242020