

State of Wisconsin

County of Oneida } ss.



I Phillip T. Hansen, do hereby certify that on the 1st day of December, 1976, I found evidence of the N 1/16 corner of Section 19 & 24 Township 36 North, Range 10 & 11 East, Fourth Principal Meridian, as described hereon; and that from this evidence I established a new monument and accessories as described hereon to perpetuate the original location of this corner.

Resident witnesses:

Glenn Barker

Jim Clarlin

Herb Wagoner

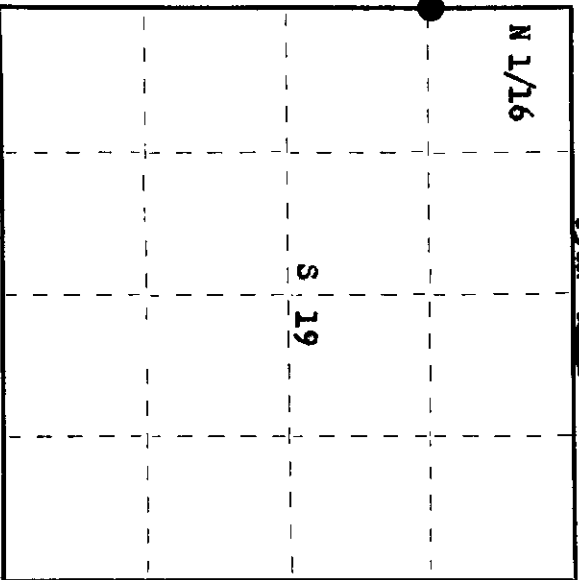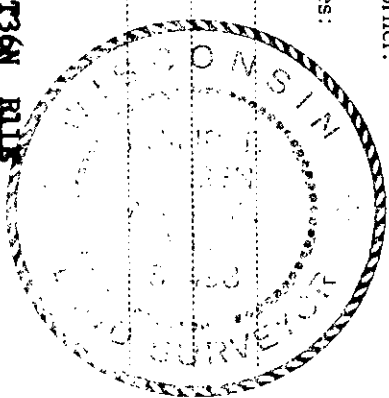

○ = Corner monument restored.

History of original corner establishment:

Corner established by D.H. Vaughan, County Surveyor. Set post and marked BTs - Cedar 10" N 63° W 26 links, Cedar 12" S 71° E 26 links. Corner recovered by H.C. Lawrence, Registered Land Surveyor. Set new post.

Description of corner evidence found:

Recovered Vaughan's 2" cedar post, point buried in the muck. Recovered Lawrence's 6" cedar post, squared and scribed N 1/16 S19, N 1/16 S24 in poor condition. Recovered OBT - Cedar 10" N 63° W 26 links, now down and decayed. Cedar 12" S 71° E 26 links, now down and decayed, BT facing visible.

Description of monument and accessories I established to perpetuate the original location of this corner.

Replaced Lawrence's cedar post with 1 1/2" iron pipe with 2" brass cap, stamped: Monument projects 12" above ground. NBT - Cedar 9" N 37° W 27 1/2 links, scribed 1/16 BT. Cedar 7" N 23° E 48 links, scribed 1/16 BT.

R S498
E T36N
R 10 N 1/16 24 19 11
E
GPI-1976

Dated at Rhinelander, Wis., this 14th day of December, 1976

Signature Phillip T. Hansen Title Registered Land Surveyor Registration No. S-498
(County Surveyor, Registered Land Surveyor, or other duly authorized official)

Office of Register of Deeds, County of Oneida. I hereby certify that the within instrument was filed in this office for record on the 7th day of February, 1977 at 145 o'clock P. M.

Laura Savage Fisher
(Register of Deeds)

By Joseph W. Barner Deputy