



CERTIFIED LAND CORNER RESTORATION

Index No. **V-25**

State of Wisconsin } ss.
 County of Oneida

I, Philip T. Hansen, do hereby certify that on the 8th day of July, 1976, I found evidence of the section corner of S. 25, 30, 36, 31 Township, 36 North, Range 10 & 11 West, Fourth Principal Meridian, as described hereon; and that from this evidence I established a new monument and accessories as described hereon to perpetuate the original location of this corner.

Resident witnesses:
 Jim Claffin
 Herb Larson

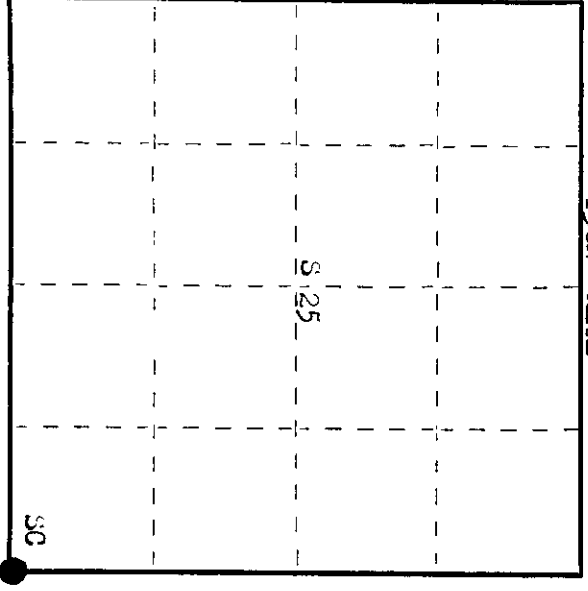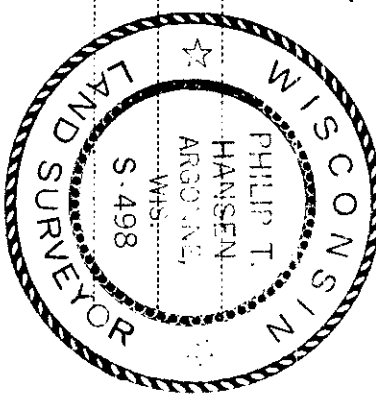

○ = Corner monument restored.

CERTIFIED LAND CORNER RESTORATION

Index No. **V-25**

History of original corner establishment: Original corner established by Hiram C. Fellows, Deputy Surveyor, in 1859, from which white pine 3" bears 3' 4" N 25 lks, spruce 10" S 150' E 27 lks, fir 10" N 77' E 25 lks, aspen 10" N 43' N 27 lks. Corner recovered by D.H. Vaughan, County Surveyor, in 1905. Corner recovered by H.C. Lawrence, registered Land Surveyor, recovered 3 old posts in fence line in 1950. Unable to find any remains of BTs. set new cedar post in place of three recovered and marked MBTs. Maple 18" N 54' N 63 lks and Cedar 7" S 80' N 14 lks.

Description of corner evidence found:
 Recovered 6" squared and scribed cedar post in poor condition, still standing, scribed S25, S30, N11E, S31 T36N R36 E10W. Corner sets in fence line running north.

Recovered MBTs - Cedar 7" (10") S 80' N 14.0 lks, scribed S 36 MBT.
 Maple 18" N 54' N 63.0 lks, scribed S 25 MBT.

Description of monument and accessories I established to perpetuate the original location of this corner.
 Replaced 6" cedar post with 2 1/2" pernuttsen #1 Federal monument stamped.

Post projects 20" above ground. 3498
 MBTs - Maple 8" due south 59.4 lks, scribed SC - BT. T36N R 11
 Maple 8" N 16' N 69.2 lks, scribed SC - BT. E 10 sec. 25 | 30
 E 36 | 31 E

Dated at Oneida, Wis., this 12th day of August, 1976

Signature *Philip T. Hansen* Title Registered Land Surveyor Registration No. S-498
 (County Surveyor, Registered Land Surveyor, or other duly authorized official)

Office of Register of Deeds, County of Oneida
 Instrument was filed in this office for record on the 27th day of August, 1976 at 1:00 o'clock P.M.
 I hereby certify that the within

Louis Vergas Krichka
 (Register of Deeds)

By _____ Deputy

3610250000