

CERTIFIED LAND CORNER RESTORATION



Index No. **S-25**

State of Wisconsin }
 County of Waushara } ss.

I Phillip T. Hansen do hereby
 certify that on the 31st day
 of September, 1976, I found
 evidence of the N 1/4
 corner of Section 25,
Township 26, North, Range
10, Fourth Principal Meridian,
 as described hereon; and that from this evidence
 I established a new monument and accessories
 as described hereon to perpetuate the original
 location of this corner.

Resident witnesses:

Alan Barker
Herb Peterson

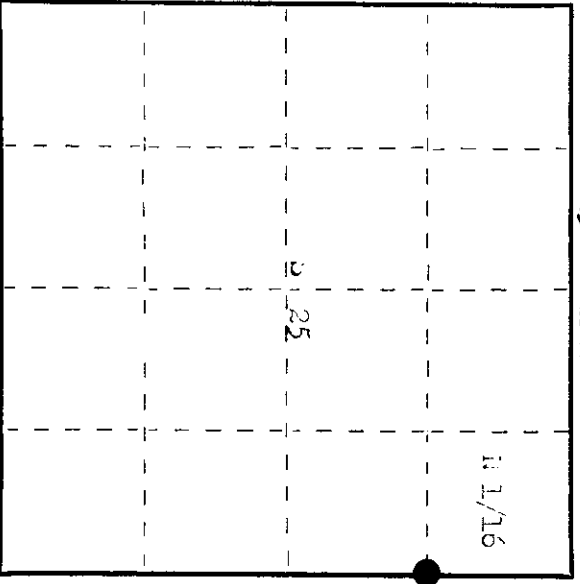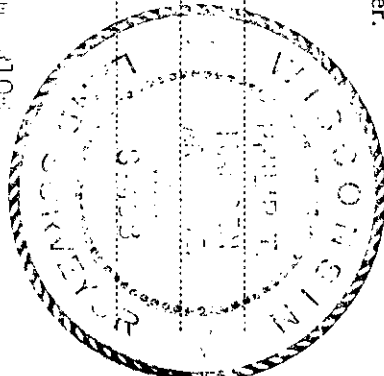

○ = Corner monument restored.

History of original corner establishment:

Corner established by D.H. Van Lan, County Surveyor, in 1905. Set post and marked D's -
 in track 100' x 30' x 35 links and barometer 80' x 30' x 40 links.
 H.C. Lawrence, registered land surveyor, recovered in 1/20' iron pipe in east southerly of road
 during his retracement survey in 1955. He set a witness post 40' from corner - 87' x 14 links.
 Placed rock cairn around base. Marker rods - red pine 150' x 47' x 174 links iron pipe.

Description of corner evidence found:

Recovered 1 1/2" iron pipe 200' below surface of road bed. No trace found of barometer witness
 post, which had been removed by road construction.
 Recovered red pine 150' x 47' x 174 links (170 links) scribbled N 1/4 S25 SWT.

Description of monument and accessories I established to perpetuate the original location of this corner.

Set a 1 1/2" iron pipe with 20' brass cap for witness corner 40 links east, staked;
 monument projects 4" above ground.
 SET - red pine 100' x 100' x 2,329 centims, scribbled N 1/4 SWT.
 Measurements and bearings from old and new are to true corner.

136m ALOE
 1 1/4 S25 SWT
 40' 40' lks.
 01-1-1976

Dated at Waushara, Wis., this 25 day of November, 1976.

Signature Phillip T. Hansen Title Registered Land Surveyor Registration No. 27426
 (County Surveyor, Registered Land Surveyor, or other duly authorized official)

Office of Register of Deeds, County of Waushara
 Instrument was filed in this office for record on the 9th day of November, 1976
 at 10:30 o'clock A. M.

Lois Savage Fisher
 (Register of Deeds)

By Phillip T. Hansen Deputy

3610 253000