

CERTIFIED LAND CORNER RESTORATION

Index No. **S-23**

State of Wisconsin

County of Oneida } ss.

I Phillip T. Hansen, do hereby

certify that on the 9th day

of June 1976, I found

evidence of the NC 1/16

corner of Section 25

Township 36, North, Range

10 East, Fourth Principal Meridian,

as described hereon; and that from this evidence

I established a new monument and accessories


as described hereon to perpetuate the original

location of this corner.

Resident witnesses:

Jim Claffin

Herb Wagoner

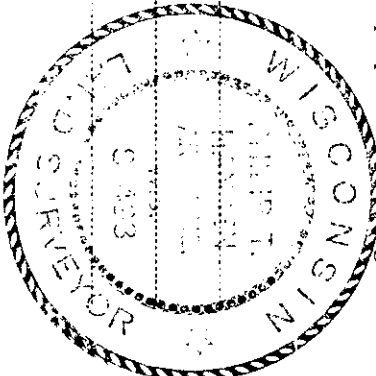

History of original corner establishment:

Corner established by D.H. Vaughan, County Surveyor, in 1905. Set Corner post and marked
BTs - White Pine 14" S 50° E 21½ lks, Birch 28" N 17° W 22 lks.

Corner recovered by H.C. Lawrence, Registered Land Surveyor, in 1951. Recovered white
Pine 14" still standing. Only rotten stump of Birch 28" remained. Set new post.

Description of corner evidence found:

Recovered Lawrence's 5" squared cedar post, scribed S 25, NC 1/16, S25, NC 1/16 in poor
condition. Post was laying down, but recovered the point intact.

Recovered BBT - White Pine 14" (38") S 50° W 21.5 lks, scribed 1/8s BT.

Description of monument and accessories I established to perpetuate the original location of this corner.

Replaced point of old post with 1 1/2" iron pipe with brass cap stamped.

Monument projects 24" above ground.

MBTs - Maple 12" S 14° E 86.8 lks, scribed 1/16 BT.

Corner sets at fence corner, fence runs North and east.

3498
T36N R10E

NC 1/16 S 25

CPI-1976


Dated at Rhineland, Wis., this 12th day of August, 1976.

Signature Phillip T. Hansen Title Registered Land Surveyor Registration No. 9498
(County Surveyor, Registered Land Surveyor, or other duly authorized official)

Office of Register of Deeds, County of Oneida I hereby certify that the within
instrument was filed in this office for record on the 12th day of September, 1976
at 10:00 o'clock M.

Steve Verage
(Register of Deeds)

By Steve Verage Deputy

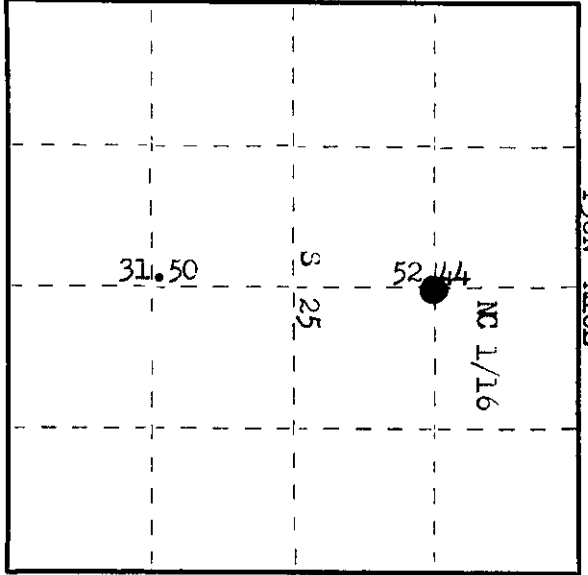

○ = Corner monument restored.

3610 25 3020