

CERTIFIED LAND CORNER RESTORATION

Index No. V-21

State of Wisconsin


County of Oneida } ss.

I Philip T. Hansen, do hereby certify that on the 11th day of November, 1975, I found evidence of the Section corner of Sections 25, 26, 35, and 36 Township 36, North, Range 10 East, Fourth Principal Meridian, as described hereon; and that from this evidence I established a new monument and accessories as described hereon to perpetuate the original location of this corner.


Resident witnesses:

Glen Barker

Jim Claffin

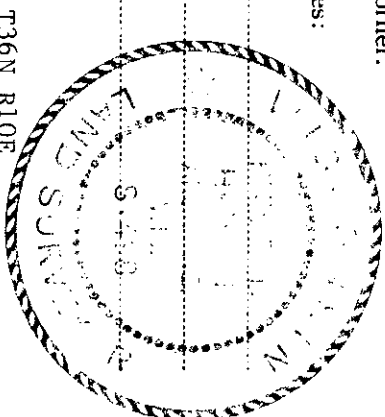

T36N R10E

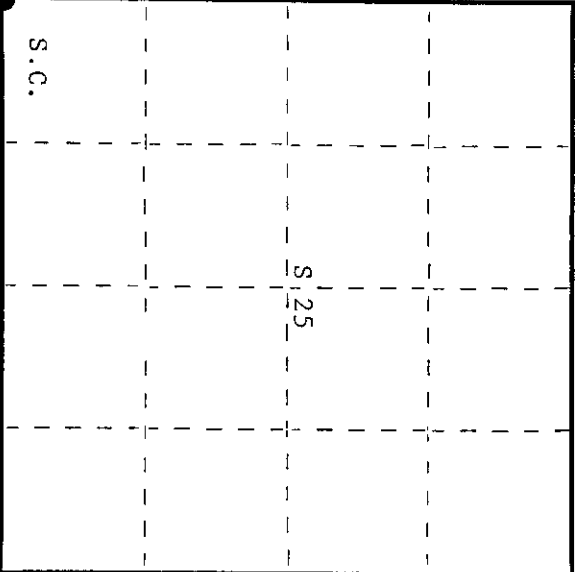

○ = Corner monument restored.

History of original corner establishment:

Original corner established by Wm. E. Dougherty, Deputy Surveyor, in 1863, from which aspen 6" bears N21°W, 65 links and yellow pine 20" bears S15°E, 40 links. Corner recovered by H.C. Hall in 1933. He states he recovered the SE BT. Set new post and marked NBT - Yellow Pine 13" N70°W 160-1/2 links. Corner recovered by H.C. Lawrence, Registered Land Surveyor, in 1951. Recovered old scribed fence post and OBT - Yellow Pine 13" N70°W 160-1/2 links
Set new cedar post and marked NBT's - Yellow Pine 14" N52°W 122-1/2 links and Yellow Pine 14" S35°W 186 links in open field.

Description of corner evidence found:

Recovered Lawrence's 4" cedar post, squared and scribed S25, S26, S35, S36, in poor condition. This corner sits in the Y of Leith Road and an old road that bears west. Recovered OBT's - N. Pine 16"(18") S35°W 186 links - scribing grown over
N. Pine 14"(16") N52°W 122.5 links - this BT was not scribed

Description of monument and accessories I established to perpetuate the original location of this corner.

Replaced Lawrence's 4" cedar post with 1-1/2" OD x 4' iron pipe, driven flush with the ground for true corner. As this is in danger of being destroyed, we set a 2-1/2" iron pipe with brass cap as a witness corner south 60 links.
Cap stamped - S498
Pipe projects 24" above ground. T36N R10E
NBT's - R. Pine 8" S74°E 74 links - scribed SG BT S
R. Pine 9" N31°W 99.3 links - scribed SG BT e 26/25 W.C.
Measurements and bearing to OBT's and NBT's from true corner. c. 35/36
Pipe and BT's painted blue. N. 60 links
CPI - 1975

Dated at Rhinelander, Wis., this 17th day of November, 1975.

Signature: Philip T. Hansen Title: Registered Land Surveyor Registration No. S-498
(County Surveyor, Registered Land Surveyor, or other duly authorized official)

Office of Register of Deeds, County of Oneida
Instrument was filed in this office for record on the 4th day of January, 1977 at 2:00 o'clock P.M.

Debra Heritage Kuehn
(Register of Deeds)

By: Deputy