

CERTIFIED LAND CORNER RESTORATION



Index No. **U-21**

State of Wisconsin

County of Oneida } ss.

I, Phillip T. Hansen, do hereby certify that on the 10th day of August, 1976, I found established the S 1/16 corner of section 25 - 26 Township 36 North, Range 10 East, Fourth Principal Meridian, as described hereon; and that from this evidence I established a new monument and accessories as described hereon to perpetuate the original location of this corner.

Resident witnesses:
 Glen Barker
 Jim Graflin
 Herb Wagoner

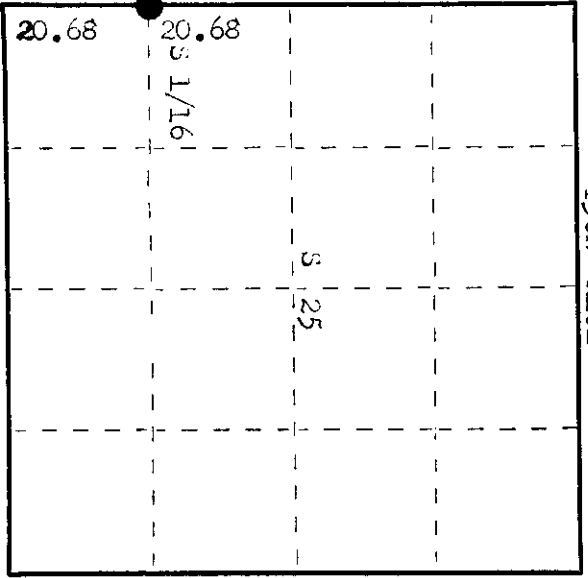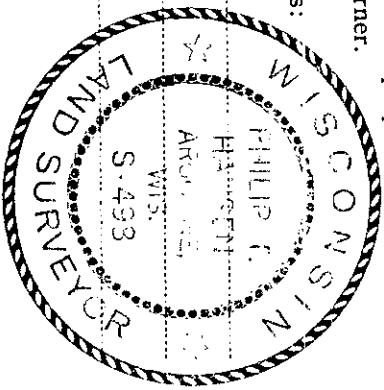

○ = Corner monument restored.

361026100

History of original corner establishment: Corner established by D.H. Vaughan, County Surveyor, in 1900, which he set from original trees when he surveyed for Lonico to Muhlenlander road. H.C. Hall recovered this corner in 1933 at 20.68 chains south of 1/4 Corner, compared to Vaughan's record distance of 20.72 chains. H.C. Lawrence, registered Land Surveyor, re-established this corner in 1951. Was unable to locate evidence of Corner. Set corner by proportional measurement. Set a white birch post 16' offset east on east side of road and marked BT for offset - white birch 6" N 52° E 47 links. Also set an offset 16 links west of Corner.

Description of corner evidence found:
 Searched for evidence of old Corner, offset and BT, but was unable to recover any evidence. Reared for evidence of old Corner, offset and BT, but was unable to recover any evidence. Ran traverse line S 1° 40' E from 1/4 corner to section Corner, 25-26-35-36. Measured distance 41.36 chains, same as D.H. Vaughan. Lawrence and Hall had 41.44. Set 1/16 on line at 20.68 chains intermediate. Corner sets in center line of left road.

Description of monument and accessories I established to perpetuate the original location of this corner.
 Drove a 1" x 2 1/2" iron pipe 4" below surface of road S 1° 40' E of 1/4 corner for true corner. Set 1 1/2" iron pipe with brass cap 35 links west for witness corner. Stamped.
 Monument projects 18" above ground.
 BT's - black spruce 3" x 68' x 52 links, scribed 1/16 BT.
 Maple 5" x 50' x 58 links, scribed 1/16 BT.
 2498
 136 1/2
 S 1/16 26 1/25 N.C.
 --35 lks.

Dated at Muhlenlander, Wis., this 23rd day of August, 1976

Signature *Phillip T. Hansen* Title Registered Land Surveyor Registration No. 498
 (County Surveyor, Registered Land Surveyor, or other duly authorized official)

Office of Register of Deeds, County of Oneida
 Instrument was filed in this office for record on the 23rd day of September, 1976 at 1:00 o'clock P.M.

Dorcas Theresa Kuehn
 (Register of Deeds)

By: Deputy