

CERTIFIED LAND CORNER RESTORATION

Index No. **T-18**

State of Wisconsin



County of Oneida } ss.

I Phillip T. Hansen, do hereby  
 certify that on the 19th day  
 of November, 1975, I found  
 evidence of the WC-1/16  
 corner of Section 26  
 Township 36, North, Range  
10 East, Fourth Principal Meridian,  
 as described hereon; and that from this evidence  
 I established a new monument and accessories  
 as described hereon to perpetuate the original  
 location of this corner.

Resident witnesses:

Glen Barker

Jim Clafin

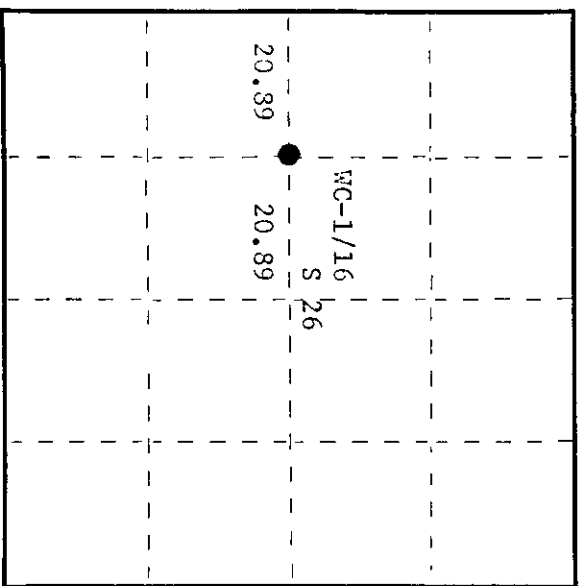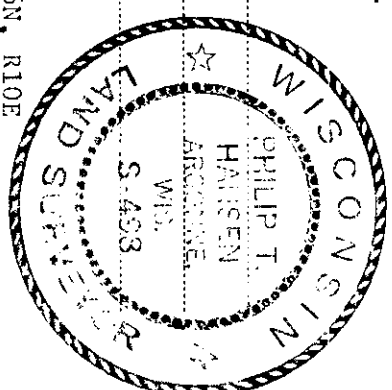

○ = Corner monument restored.

History of original corner establishment:

Original corner established by D.H. Vaughan, County Surveyor, in 1905. Set NBT's, tamarack 6", N89°W, 5 lks. and spruce 6", S42°E, 47-1/2 lks.

Corner recovered by H.C. Lawrence, Registered Land Surveyor, in 1947. Recovered Vaughan's BT's and set new 3" cedar post from them.

Description of corner evidence found:

Recovered 3" cedar post, squared and scribed WC-1/16 S26, in poor condition.

Recovered 0BT's - Tamarack 6" N89°W 5 lks. now a decayed stump  
 Spruce 6" S42°E 47.5 lks. now a decayed stump

Description of monument and accessories I established to perpetuate the original location of this corner.

Replaced 3" cedar post with 1-1/2" O.D. Iron pipe with 2" brass cap stamped -  
 Pipe projects 18" above ground.

NBT's - Tamarack 6" N60°E 22 lks. scribed 1/16 BT S498  
 Tamarack 7" S34°W 11.4 lks. scribed 1/16 BT T36N, R10E  
 Pipe and BT's painted blue.

WC-1/16 S 26  
 CPT-1975

Dated at Rhineland, Wis., this 2nd day of December, 1975

Signature Phillip T. Hansen Title Registered Land Surveyor Registration No. S-498  
 (County Surveyor, Registered Land Surveyor, or other duly authorized official)

Office of Register of Deeds, County of Oneida  
 Instrument was filed in this office for record on the 17th day of December, 1975  
 at 1:00 o'clock P. M.

James Thomas Kuhn  
 (Register of Deeds)

By James Thomas Kuhn Deputy

361026 2030