

CERTIFIED LAND CORNER RESTORATION

Index No. **S-19**

State of Wisconsin

County of **Oneida**

} ss.

I **Phillip T. Hansen**

certify that on the **17th**

of **January**, 19**77**, I found

evidence of the **NC 1/16**

corner of **Section 26**

Township **36**

**10 East**, North, Range

**10 East**, Fourth Principal Meridian,



as described hereon; and that from this evidence I established a new monument and accessories as described hereon to perpetuate the original location of this corner.

Resident witnesses:

**Glen Barker**

**Jim Clarlin**

**Herb Wagoner**

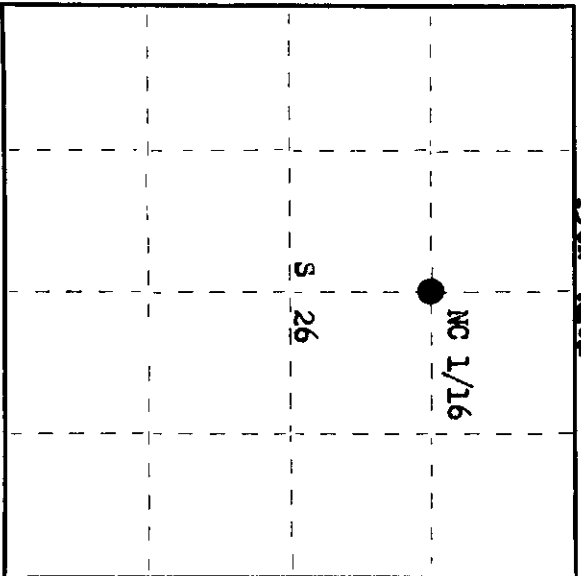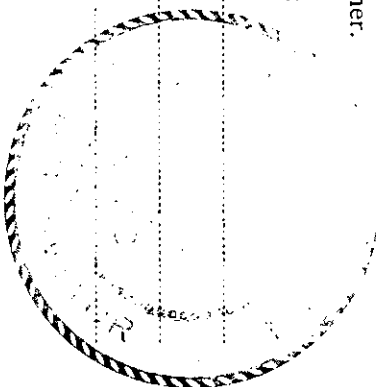

History of original corner establishment:  
Corner established by D.H. Vaughan, County Surveyor, in 1905. Set post and marked BT - White Pine 14" N 43 1/2° W 32 1/2 links.

H.C. Lawrence, Registered Land Surveyor, recovered corner in 1954. Set new post and marked NBT - White Spruce 10" N 22° W 69 1/2 links and White Pine 7" N 4° E 103 links.

Description of corner evidence found:

Recovered 5" cedar post, squared and scribed NC 1/16 S26 NC 1/16. Post was in very poor condition.

Recovered OBTs - Vaughan's White Pine stump 14" N 43 1/2° W 32.5 links. There was a cedar stake scribed BT driven in center of stump.  
Lawrence's White Pine 7" (16") N 4° E 103 links, scribing partly visible.

Description of monument and accessories I established to perpetuate the original location of this corner.

Replaced 5" cedar post with 1 1/2" OD iron pipe with 2" brass cap stamped:

Monument projects 18" above ground.

The corner sets on the southeast end of a narrow balsam and aspen ridge.

No suitable trees available for additional BTs.

S498

T36N R10E

S 26

NC 1/16

CPI-1977

Dated at **Rhinelander**, Wis., this **20th** day of **January**, 19**77**

Signature **Phillip T. Hansen** Title **Registered Land Surveyor** Registration No. **S-498**  
(County Surveyor, Registered Land Surveyor, or other duly authorized official)

Office of Register of Deeds, County of **Oneida**  
Instrument was filed in this office for record on the **24th** day of **February**, 19**77**  
at **100** o'clock **P.** M.

**Doris Norager Fuchs**  
(Register of Deeds)

By: \_\_\_\_\_ Deputy

3610263020