

CERTIFIED LAND CORNER RESTORATION



Index No. 1-16

State of Wisconsin

County of Oneida } ss.

I Phillip T. Hansen, do hereby certify that on the 18th day of November, 1975, I found evidence of the E-1/16 corner of Sections 27 and 34 Township 36, North, Range 10 East, Fourth Principal Meridian, as described hereon; and that from this evidence I established a new monument and accessories as described hereon to perpetuate the original location of this corner.

Resident witnesses:
Glen Barker
Jim Claflin

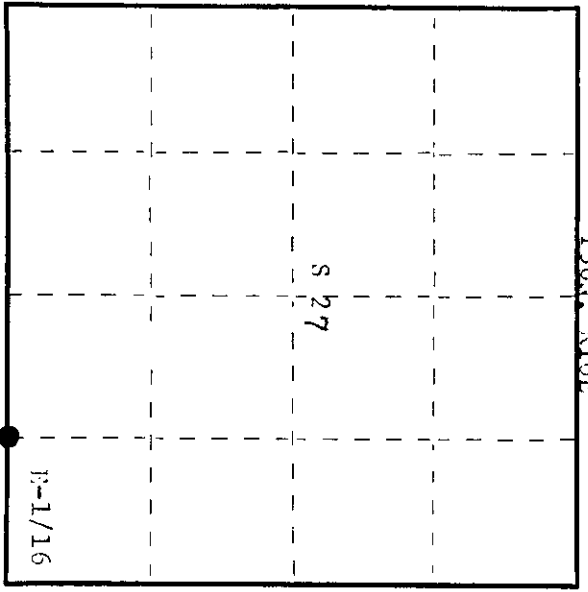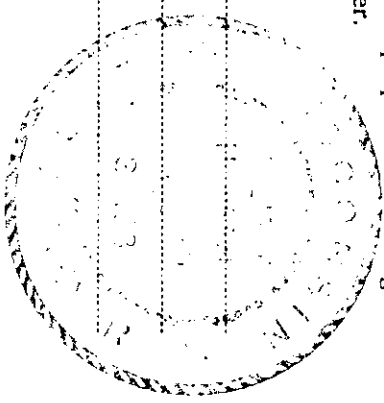

○ = Corner monument restored.

History of original corner establishment:

Corner established by D.H. Vaughan, County Surveyor, in 1905, from which hemlock 10" bears N21°W, 5-3/4 lks. and yellow pine 20" bears S-10-1/2E, 48 lks.
Corner recovered by H.C. Lawrence, Registered Land Surveyor, in 1947. Set NBT hemlock 10", S36°W, 44.7 lks. Also new cedar post.

Description of corner evidence found:

Recovered 4" cedar post, squared and scribed E-1/16 S27, E-1/16 S34 in poor condition.
Recovered ORT's - Hemlock 10" N21°W 5-3/4 lks. now a decayed stump BT visible
Y. pine 20" S10-1/2°E 48 lks. now a decayed stump
Hemlock 11" S36°W 44.7 lks. scribed E-1/16 S34 NBT

Description of monument and accessories I established to perpetuate the original location of this corner.

Replaced 4" cedar post with 1" iron pipe with 2" brass cap stamped - S498
Pipe projects 18" above ground. T36N, R10E
NBT's - Maple 6" N62°W 20 lks. scribed 1/16 BT
W. birch 3" N70°E 16.4 lks. scribed 1/16 BT

S27
E-1/16 5 34
CPI-1975

Dated at Rhineland, Wis., this 18th day of November, 1975

Signature Phillip T. Hansen Title Registered Land Surveyor Registration No. S-498
(County Surveyor, Registered Land Surveyor, or other duly authorized official)

Office of Register of Deeds, County of Oneida
Instrument was filed in this office for record on the 18th day of November, 1975
at 1:30 o'clock P.M. I hereby certify that the within

Phillip T. Hansen
(Register of Deeds)

By Phillip T. Hansen Deputy

3610270010