

CERTIFIED LAND CORNER RESTORATION

Index No. **V-15**

State of Wisconsin



County of Oneida } ss.

I Philip T. Hansen do hereby certify that on the 18th day of November, 1975, I found evidence of the Quarter corner of Sections 27 and 34 Township 36 North, Range 10 East, Fourth Principal Meridian, as described hereon; and that from this evidence I established a new monument and accessories as described hereon to perpetuate the original location of this corner.

Resident witnesses:

Glen Barker

Jim Claffin

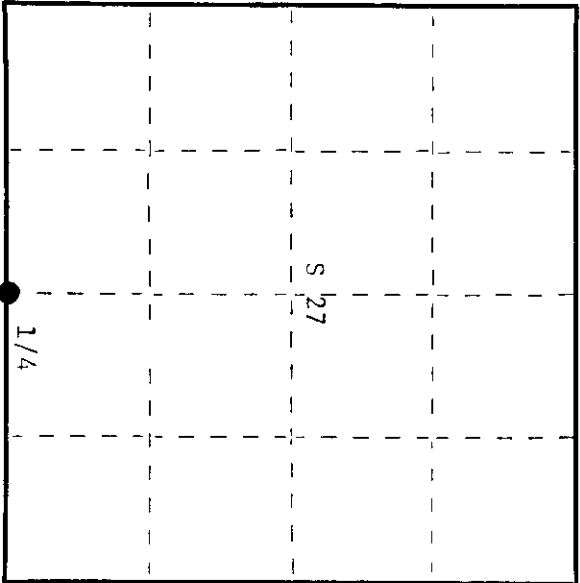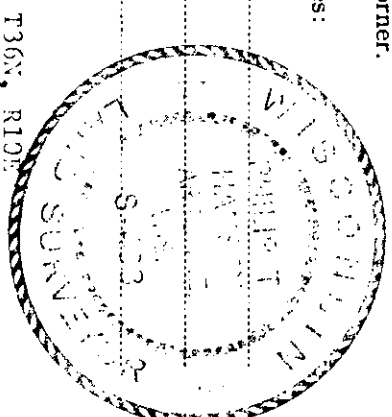

○ = Corner monument restored.

History of original corner establishment:

Original corner established by Wm. F. Dougherty, Deputy Surveyor, in 1863, from which maple 10" bears N44°E, 22 lks. and birch 10" bears S12°W, 9 lks.

Corner recovered by H.C. Lawrence, Registered Land Surveyor, in 1947, recovered an old wood post and OBT. Maple 10", N44°E, 22 lks. and birch 10", S12°W, 9 lks. Also found an iron pipe, origin unknown. Set beside old stake. Set new wood post beside old stake and iron pipe.

Description of corner evidence found:

Recovered 4" cedar post, squared and scribed 1/4S S27, 1/4S S34 in poor condition. Recovered a 2-1/2" iron pipe with brass cap, not scribed, also an old point of wooden stake beside it.

Recovered original maple 10", N44°E, 22 lks., now a decayed stump. Lawrence had driven a squared stake in center of maple stump, scribed BT.

Recovered a decayed mound where original birch once stood.

Description of monument and accessories I established to perpetuate the original location of this corner.

As iron pipe was well set and in perfect condition, we left it as is and stamped it - Pipe projects 24" above ground.

Set Lawrence's 4" cedar post beside it.

MBT's - Hemlock 10" N23°W 56 lks. scribed 1/4 BT

" W. Birch 9" S26°E 25.5 lks. scribed 1/4 BT

Painted pipe, post, and BT's blue.

1/4 S|27
S|34

CPI-1975

Dated at Oneida, Wis., this 2nd day of December, 1975.

Signature *Philip T. Hansen* Title Registered Land Surveyor Registration No. S-498
(County Surveyor, Registered Land Surveyor, or other duly authorized official)

Office of Register of Deeds, County of Oneida
at *Oneida* o'clock M. I hereby certify that the within instrument was filed in this office for record on the *17th* day of *January*, 1975.

James H. Kuebel
(Register of Deeds)

By Deputy

02027002036