

CERTIFIED LAND CORNER RESTORATION



Index No. **7-17**

State of Wisconsin

County of Oneida } ss.

I Phillip T. Hansen, do hereby certify that on the 18th day of November, 1975, I found evidence of the Quarter corner of Sections 26 and 27 Township 36 North, Range 10 East, Fourth Principal Meridian, as described hereon; and that from this evidence I established a new monument and accessories as described hereon to perpetuate the original location of this corner.

Resident witnesses:
Glen Barker
Jim Claffin

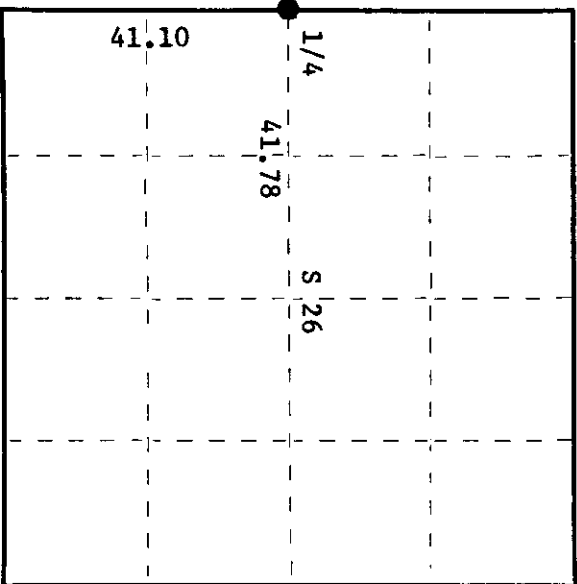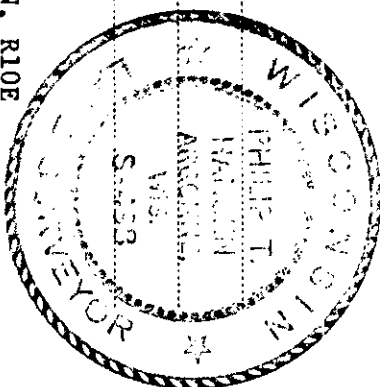

○ = Corner monument restored.

History of original corner establishment:

Corner established by Wm. E. Dougherty, Deputy Surveyor, in 1863, from which birch 10" bears S38°W, 19 lks. and hemlock 12" bears N45°E, 12 lks. Corner re-established by D.H. Vaughan, County Surveyor, in 1900. Corner searched for by H.C. Lawrence, Registered Land Surveyor, in 1947, was unable to locate corner or BT's.

Re-established corner. Ran random line from SW corner to NW corner, which had been re-covered by Vaughan, and were still intact. Set 1/4 corner at 41.10 chains North of SW corner and 41.78 chains West of Vaughan's C-1/4 corner. Set 4" cedar post. No record of NBT's set.

Description of corner evidence found:

Recovered 4" cedar post, squared and scribed 1/4S S26, 1/4S S27 in poor condition. Also a 1" iron pipe beside it painted red. No OBT's recovered.

Description of monument and accessories I established to perpetuate the original location of this corner.

- Replaced 4" cedar post with 2-1/2" iron pipe with brass cap stamped - S498
- Pipe projects 24" above ground. T36N, R10E
- NBT's - Maple 6" N28°E 28 lks. scribed 1/4 BT
- Maple 6" S40°W 34.5 lks. scribed 1/4 BT
- Pipe and NBT's painted blue. S27/S26

1/4

OPI-1975

Dated at Rhinelander, Wis., this 1st day of December, 1975

Signature Phillip T. Hansen Title Registered Land Surveyor Registration No. S-498
 (County Surveyor, Registered Land Surveyor, or other duly authorized official)

Office of Register of Deeds, County of Oneida, I hereby certify that the within instrument was filed in this office for record on the 18th day of November, 1975 at 1:00 o'clock P.M.

Doris M. Kisch
 (Register of Deeds)

By _____ Deputy

3610272000

