

CERTIFIED LAND CORNER RESTORATION



Index No. F-16

State of Wisconsin

County of Oneida } ss.

I Phillip T. Hansen, do hereby certify that on the 27th day of July, 1979, I found ~~restored~~ established the EC 1/16 corner of Section 27, Township 36, North, Range 10 East, Fourth Principal Meridian, as described hereon; and that from this evidence I established a new monument and accessories as described hereon to perpetuate the original location of this corner.

Resident witnesses:
Glen Barker
Jim Clafflin
Herb Wagoner

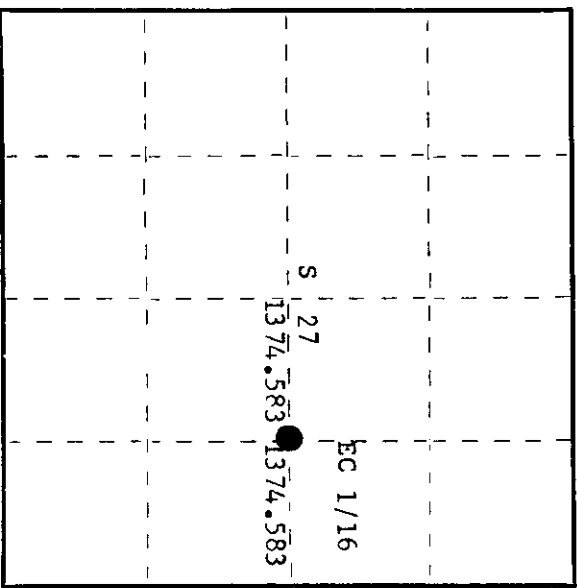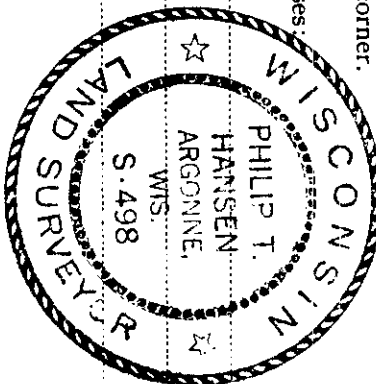

○ = Corner monument restored.

History of original corner establishment:

Corner established by D.H. Vaughan, County Surveyor, in 1905.
Marked Birch 16" S82-1/2°E 20 links, Birch 8" S84°W 30-1/2 links.
H.C. Lawrence, Registered Land Surveyor, searched for but was unable to locate corner or BT's in 1947.

Description of corner evidence found:

No evidence of any corner recovered.
Corner established by traverse and computation. Computed distance from C 1/4 corner to E 1/4 corner is 2749.165 feet at bearing S 87° 50' 40" E. Set EC 1/16 at 1374.583 feet intermediate.

Description of monument and accessories I established to perpetuate the original location of this corner.

Set a 1-1/2" iron pipe with 2" brass cap for corner. Cap stamped:
Monument projects 24" above ground. Built a rock cairn around base of monument.
Monument sets 65' north of centerline of old highway 8.

Marked NBT's -
B. Spruce 6" S85°E 15.72 feet
B. Spruce 7" N40°W 20.00 feet
both scribed 1/16 BT.
S498
T36N R10E
S 27
EC 1/16
CPI-1979

Dated at Rhineland, Wis., this 31st day of July, 1979.

Signature Phillip T. Hansen Title Registered Land Surveyor Registration No. S-498
(County Surveyor, Registered Land Surveyor, or other duly authorized official)

Office of Register of Deeds, County of Oneida. I hereby certify that the within instrument was filed in this office for record on the 7th day of August, 1979 at 1:00 o'clock P. M.

Doris George Fischer
(Register of Deeds)

By Doris George Fischer Deputy

3610272010