

CERTIFIED LAND CORNER RESTORATION



Index No. 7-14

State of Wisconsin

County of Oneida } ss.

I Phillip T. Hansen, do hereby certify that on the 27th day of July, 19 79, I ~~found~~ restored the WC 1/16 corner of Section 27 Township 36, North, Range 10 East, Fourth Principal Meridian, as described hereon; and that from this evidence I established a new monument and accessories as described hereon to perpetuate the original location of this corner.

Resident witnesses:
Glen Barker
Jim Claflin
Herb Wagoner

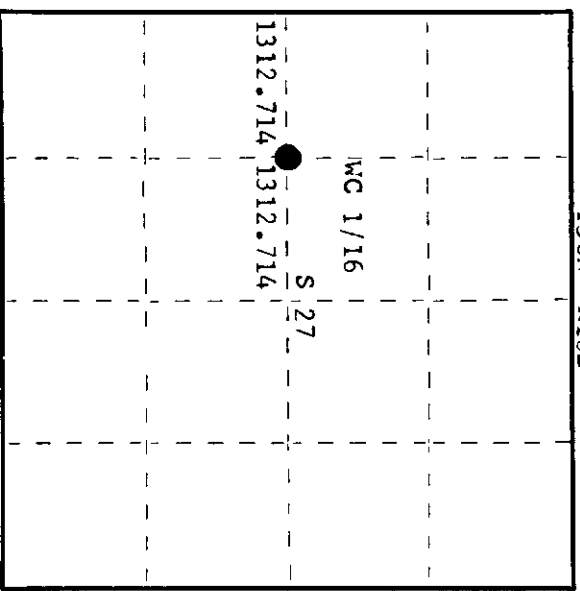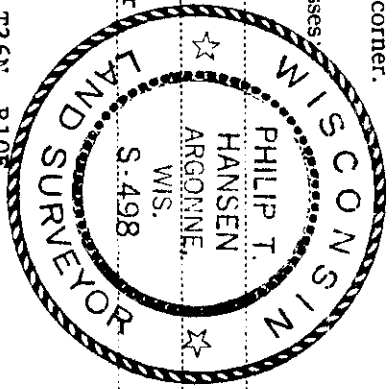

○ = Corner monument restored.

History of original corner establishment:

Corner established by D.H. Vaughan, County Surveyor, in 1905.
Marked Tamarack 6" N89°W 5 links
Spruce 6" S42°E 47-1/2 links

Description of corner evidence found:

No evidence of corner recovered.
Corner established by traverse and computation. Computed distance from previously established W 1/4 to C 1/4 corners is 2625.428 feet at bearing S 87° 50' 40" E.
Set WC 1/16 corner at 1312.714 feet intermediate.

Description of monument and accessories I established to perpetuate the original location of this corner.

Set 1-1/2" iron pipe with 2" brass cap, stamped:
Monument projects 24" above ground. Built rock cairn around base of monument.
Marked NBT's - S498
White Birch 8" S77°W 20.88 feet T36N R10E
Maple 9" S10°E 58.20 feet, scribed 1/16 RT. WC 1/16 S 27
CPI-1979

Dated at Rhinelander, Wis., this 31st day of July, 19 79.

Signature Phillip T. Hansen Title Registered Land Surveyor Registration No. S-498
(County Surveyor, Registered Land Surveyor, or other duly authorized official)
Office of Register of Deeds, County of Oneida
at 1:00 o'clock P. M. I hereby certify that the within instrument was filed in this office for record on the 7th day of August, 19 79.

Terese Neugebauer
(Register of Deeds)

By Deputy

3610272030