

CERTIFIED LAND CORNER RESTORATION



Index No. V-12

State of Wisconsin

County of _____ } ss.

I, _____, do hereby certify that on the _____ day of _____, 19__ I found evidence of the _____ corner of _____ Township _____ North, Range _____ Fourth Principal Meridian, as described hereon; and that from this evidence I established a new monument and accessories as described hereon to perpetuate the original location of this corner.

Resident witnesses:

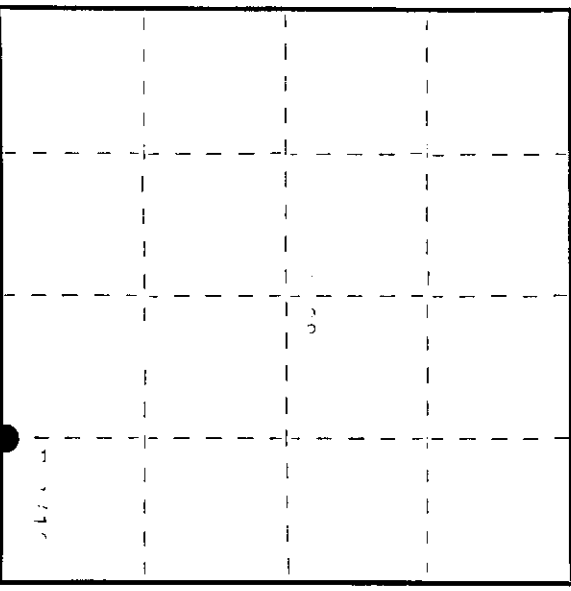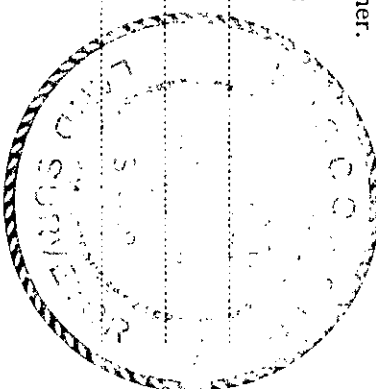

○ = Corner monument restored.

History of original corner establishment:

Corner established by _____ of _____ County, Wisconsin, on _____ day of _____, 19__.

Description of corner evidence found:

Corner evidence found as follows: _____

Description of monument and accessories I established to perpetuate the original location of this corner:

Monument and accessories established as follows: _____

Dated at _____, Wis., this _____ day of _____, 19__

Signature Walter P. Schmitt Title _____ Registration No. _____
(County Surveyor, Registered Land Surveyor, or other duly authorized official)

Office of Register of Deeds, County of _____
Instrument was filed in this office for record on the _____ day of _____, 19__ at _____ o'clock _____ M.

Signature Walter P. Schmitt
(Register of Deeds)

By _____ Deputy

3610280010