

CERTIFIED LAND CORNER RESTORATION


Index No. V-11

State of Wisconsin




Resident witnesses:

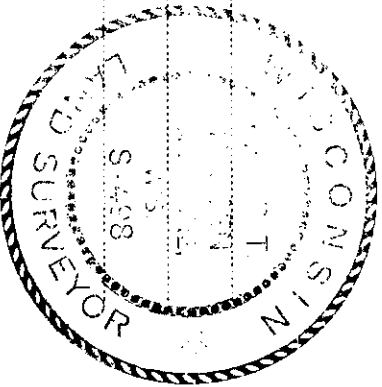

History of original corner establishment:

Description of corner evidence found:

Description of monument and accessories I established to perpetuate the original location of this corner.

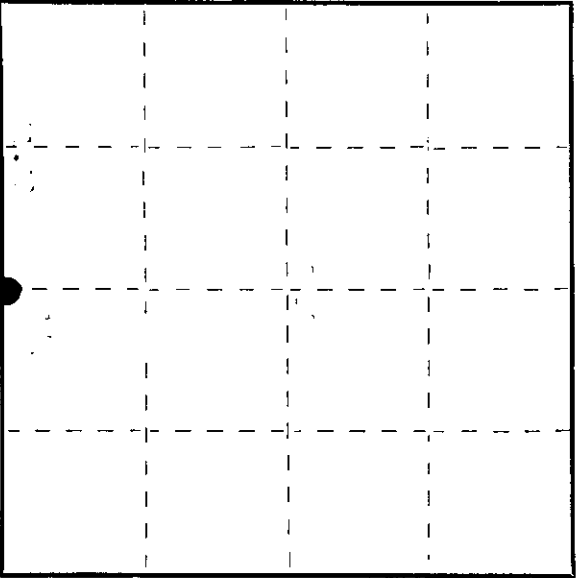

○ = Corner monument restored.


(County Surveyor, Registered Land Surveyor, or other duly authorized official)

at 1:00 o'clock P. M. Thereby certify that the within

Lance Hanna (Register of Deeds)

By Lance Hanna Deputy

361428020