

CERTIFIED LAND CORNER RESTORATION

Index No. U-13

State of Wisconsin



County of Oneida } ss.

I Phillip T. Hansen, do hereby certify that on the 19th day of November 1975, I found evidence of the S-1/16 corner of Sections 27 and 28 Township 36, North, Range 10 East, Fourth Principal Meridian, as described hereon; and that from this evidence I established a new monument and accessories as described hereon to perpetuate the original location of this corner.

Resident witnesses:

Glen Barker

Jim Clafin

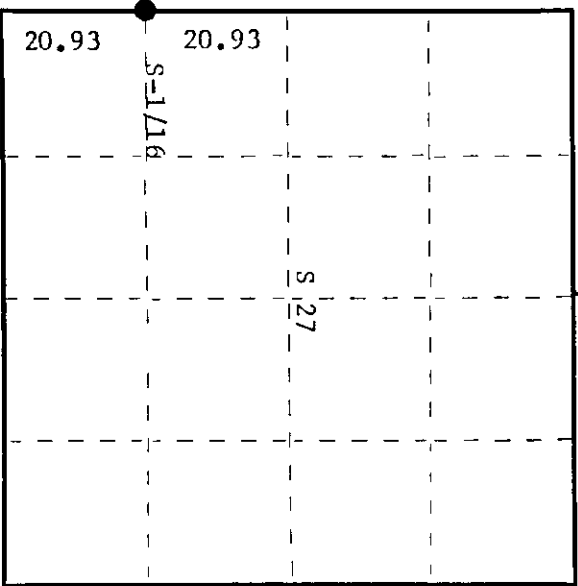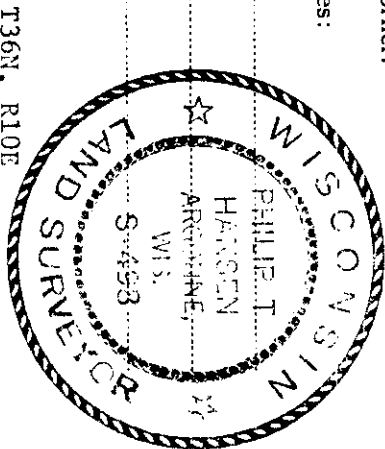

○ = Corner monument restored.

History of original corner establishment:

Corner established by B.F. Dorr, County Surveyor, in 1886. Set cedar post from which aspen 7" bears S50°E, 8 lks.

Corner recovered by H.C. Lawrence, Registered Land Surveyor, in 1948. Found the remains of his old post. The aspen 7" was down and almost buried.

Description of corner evidence found:

Recovered 4" cedar post, squared and scribed S-1/16 S27, S-1/16 S28 in poor condition.

Recovered OBT's - White pine 20" S75°W 116 lks. scribed S-1/16 NBT
White pine 18" N87°W 79.7 lks. scribed S-1/16 NBT

These are Lawrence's BT's, but was unable to locate any notes on them.

Description of monument and accessories I established to perpetuate the original location of this corner.

Replaced 4" cedar post with 1" O.D. iron pipe with 2" brass cap stamped -
Pipe projects 18" above ground. S498
No additional accessories established. T36N, R10E
Pipe and OBT's painted blue. S28 | S27
S-1/16 |

CPI-1975

Dated at Rhinelander, Wis. this 2nd day of December, 1975.

Signature Phillip T. Hansen Title Registered Land Surveyor Registration No. S-498
(County Surveyor, Registered Land Surveyor, or other duly authorized official)

Office of Register of Deeds, County of Oneida. I hereby certify that the within instrument was filed in this office for record on the 4th day of December, 1975 at 1:30 o'clock P.M.

James M. K... (Register of Deeds)

By Deputy

3610281000