

CERTIFIED LAND CORNER RESTORATION

Index No. U-10

State of Wisconsin

ss.

County of _____

I, _____, do hereby certify that on the _____ day of _____, 19__

evidence of the _____

corner of _____, North, Range _____, Township _____, Fourth Principal Meridian,



as described hereon; and that from this evidence

I established a new monument and accessories

as described hereon to perpetuate the original

location of this corner.

Resident witnesses:

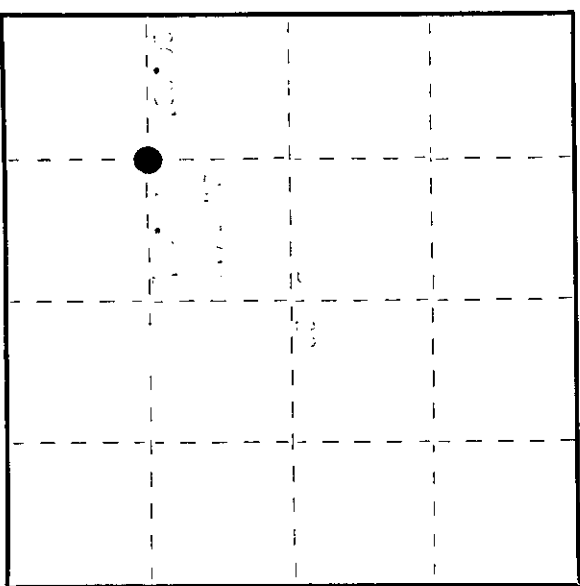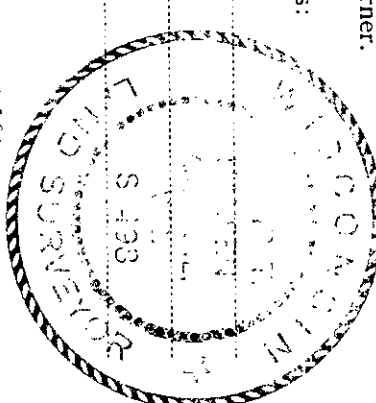

○ = Corner monument restored.

History of original corner establishment:

Description of corner evidence found:

Description of monument and accessories I established to perpetuate the original location of this corner.

Dated at _____, Wis., this _____ day of _____, 19__

Signature _____ Title _____ Registration No. _____
(County Surveyor, Registered Land Surveyor, or other duly authorized official)

Office of Register of Deeds, County of _____
Instrument was filed in this office for record on the _____ day of _____, 19__
at _____ o'clock _____ M.

(Register of Deeds)

By _____ Deputy

3610281030