

CERTIFIED LAND CORNER RESTORATION

Index No. **7-13**



State of Wisconsin

County of Oneida } ss.

I Phillip T. Hansen do hereby certify that on the 19th day of November, 1975, I found evidence of the quarter corner of Sections 27 and 28 Township 36 North, Range 10 East, Fourth Principal Meridian, as described hereon; and that from this evidence I established a new monument and accessories as described hereon to perpetuate the original location of this corner.

Resident witnesses:

Glen Barker
Jim Claflin

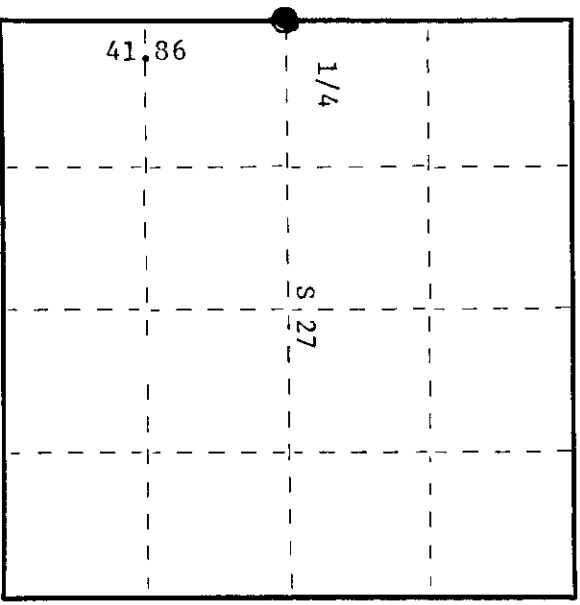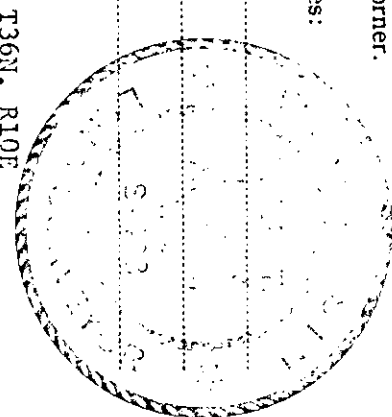

○ = Corner monument restored.

History of original corner establishment:

Original corner established by Wm. E. Dougherty, Deputy Surveyor, in 1863 from which birch 10" bears N81°E, 32 lks. and tamarack 8" bears S80°W, 16 lks. Corner recovered and restored by D.H. Vaughan, County Surveyor, in 1905. Set new post and marked NBT's, spruce 10", N4-1/2°W, 47 lks. and spruce 7", N66-1/2°E, 33 lks. Corner recovered by H.C. Lawrence, Registered Land Surveyor, in 1948. Found Vaughan's post and BT's intact. Set new cedar post and marked NBT's - white birch 9", S12°E, 19 lks. and spruce 8", N72°W, 40 lks.

Description of corner evidence found:

Recovered Lawrence's 5" cedar post, squared and scribed 1/4S S27, 1/4S S28 in fair condition. Also a 2-1/2" iron pipe with brass cap scribed S28-1/4 S27 setting beside wooden post. Original BT's now decayed mounds.

Recovered OBT's - White birch 9" (10") S12°E 19 lks. scribed 1/4 S27 NBT
B. spruce 8" N72°W 40 lks. now down and dead

Description of monument and accessories I established to perpetuate the original location of this corner. Calls to BT's fit the iron pipe more accurately than to the wooden post. Stamped brass cap with T36N, R10E and left it in place.

Pipe projects 18" above ground. 24.4 lks. scribed 1/4 BT
NBT's - B. spruce 6" S48°E 548°E 44.8 lks. scribed 1/4 BT
B. spruce 6" N34°E 44.8 lks. scribed 1/4 BT
Pipe and NBT's painted blue.

Dated at Rhinelander, Wis. this 2nd day of December, 1975.

Signature: *Phillip T. Hansen* Title: Registered Land Surveyor Registration No. S-498
(County Surveyor, Registered Land Surveyor, or other duly authorized official)

Office of Register of Deeds, County of Oneida
Instrument was filed in this office for record on the 4th day of December, 1975 at 1:00 o'clock P.M.
I hereby certify that the within

Signature: *Thomas George Kitchin*
(Register of Deeds)

By: Deputy

3610282000