

CERTIFIED LAND CORNER RESTORATION



Index No. **S-11**

State of Wisconsin

County of _____ } ss.

I _____, do hereby certify that on the _____ day of _____, 19____, I found evidence of the _____ corner of _____ Township _____ North, Range _____ Fourth Principal Meridian, as described hereon; and that from this evidence I established a new monument and accessories as described hereon to perpetuate the original location of this corner.

Resident witnesses:

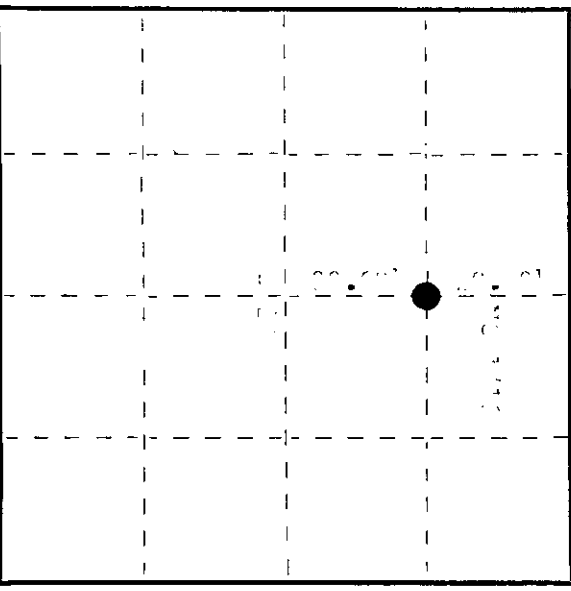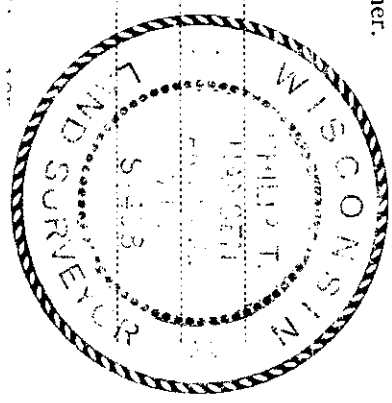

○ = Corner monument restored.

History of original corner establishment:

Description of corner evidence found:

Description of monument and accessories I established to perpetuate the original location of this corner.

Dated at _____, Wis., this _____ day of _____, 19____

Signature *Julio DeStamant* Title _____ Registration No. _____
(County Surveyor, Registered Land Surveyor, or other duly authorized official)

Office of Registrar of Deeds, County of _____
I hereby certify that the within instrument was filed in this office for record on the _____ day of _____, 19____ at _____ o'clock _____ M.

Signature *Robert A. Kuchner*
(Registrar of Deeds)

By _____ Deputy

3610283020