CERTIFIED LAND CORNER RESTORATION

Index No. V-9

State of Wisconsin
County of Oneida } ss.

I Philip T. Hansen, do hereby certify that on the 10th day of September, 19 75, I found evidence of the Section Corner corner of S28, S29, S32, and S33 Township 36, North, Range 10E, Fourth Principal Meridian, as described hereon; and that from this evidence I established a new monument and accessories as described hereon to perpetuate the original location of this corner.

Resident witnesses:

Glen Barker

Jim Claflin

T36N, R10E

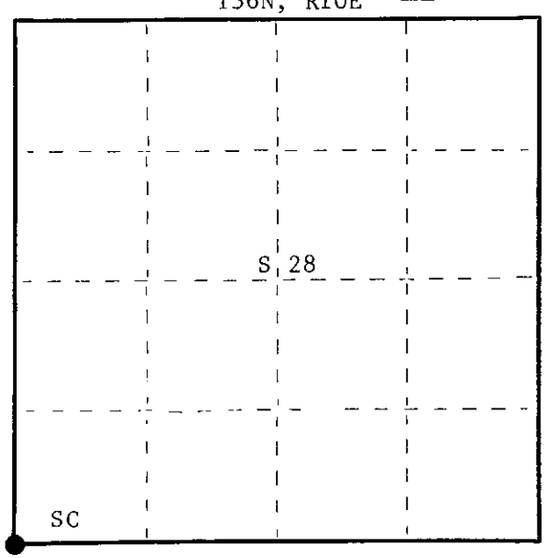

○ = Corner monument restored.

History of original corner establishment:
Original corner established by Wm. E. Dougherty, Gov. Deputy Surveyor, in 1863 from which white pine 10" bears N52°W 25 links and aspen 8" bears S58°E 17 links. Corner re-established by H.C. Lawrence, Reg. Land Surveyor, in 1948. He ran the line between Sections 28 and 29 from an iron pipe set in old Highway 8 which was set from Dorr's Norway pine BT at 42.32; recovered D.H. Vaughan's 1/4 post. Continued on line S0°30'W; at 21.22 recovered Vaughan's S-1/4 post, 24 links east. Continued south and at 42.44 searched for his Section Corner 48 links east but unable to locate corner. Set new post at Vaughan's distance, marked 3" cherry N15°W 7 links for BT. Corner is in open old camp ground.

Description of corner evidence found:
Recovered 4" cedar post, squared and scribed S28, S29, S32, S33 in fair condition. Also recovered a 2" galvanized pipe with aluminum cap. Scribed -

Recovered OBT. B. cherry 3" N15°W 11 links. Now a stump. BT scribe marks still visible.
B. spruce 7" S60°W 60.7 links. Scribed S32 BT.
B. spruce 7" N66°W 42.2 links. Scribing grown over.

T36N R10E
S29 | S28
S32 | S33
Ripco

Description of monument and accessories I established to perpetuate the original location of this corner.
Ripco post did not have an anchor or flange so it was readily removed from ground. Replaced with 2-1/2" iron pipe with brass cap stamped -

NBT - Black spruce 7" south 56.3 links scribed SC BT.

S498
T36N R10E
S29 | S28
S32 | S33
CPI-1975

Dated at Rhinelander, Wis., this 22nd day of September, 19 75.

Signature Philip T. Hansen Title Registered Land Surveyor Registration No. S-498
(County Surveyor, Registered Land Surveyor, or other duly authorized official)

Office of Register of Deeds, County of Oneida I hereby certify that the within instrument was filed in this office for record on the 17th day of November 19 75 at 10:00 o'clock a M.

Doris Verage Kuehn
(Register of Deeds)

By ..... Deputy

FORM 985 H C MILLER CO., MILWAUKEE

36102900