

CERTIFIED LAND CORNER RESTORATION

Index No. **U9**

State of Wisconsin

County of Oneida } ss.


I Phillip T. Hansen, do hereby certify that on the 10th day of September, 1975, I found evidence of the S-1/16 corner of Sections 28 and 29 Township 36, North, Range 10 East, Fourth Principal Meridian,

as described hereon; and that from this evidence I established a new monument and accessories as described hereon to perpetuate the original location of this corner.


Resident witnesses:

Glen Barker

Jim Claflin

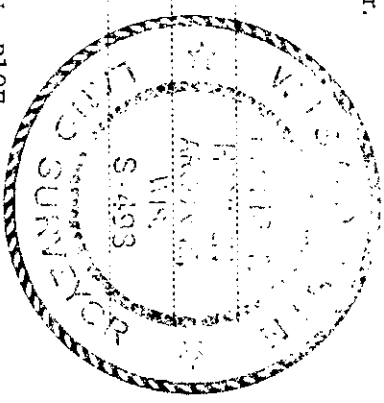

T36N, R10E

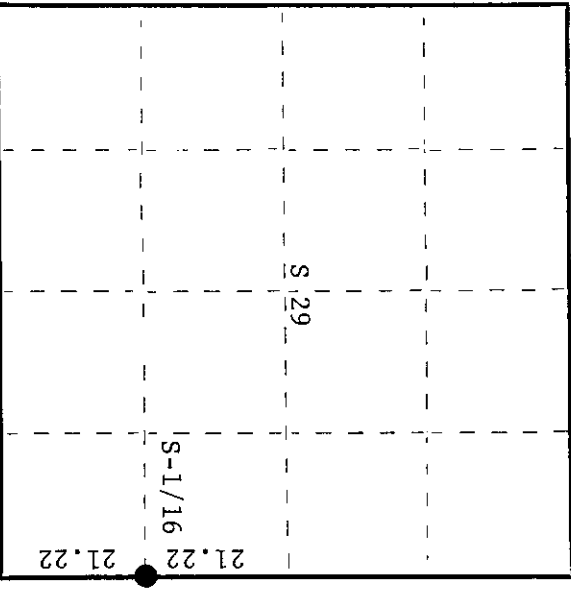

History of original corner establishment:
Original corner established by D.H. Vaughan, County Surveyor, in 1905.
Corner recovered and restored by H.C. Lawrence, Registered Land Surveyor, in 1948. From recovered 1/4 corner, between Sections 28 and 29, he ran S0°30'W and at a distance of 21.22 chains he recovered Vaughan's S-1/16 corner 24 links East. No BT's were found. Set new tamarack post and marked NBT tamarack 5", S25°W, 7 links.

Description of corner evidence found:

Recovered 3" cedar post, squared and scribed S-1/16 S28, S-1/16 S29, in poor condition.
Also recovered two old points in the muck beside post. Also recovered a 1" iron pipe with aluminum cap stamped -

The Ripco iron pipe has no flange at bottom and can be pulled easily.
Recovered OBT's - Tamarack stub S25°W 7.0 links scribed S-1/16 RT
Tamarack 5" S62°W 33.3 links scribed 1/16 BT
Tamarack 7" N70°W 69.4 links scribed 1/16 BT

Description of monument and accessories I established to perpetuate the original location of this corner.
Replaced Ripco iron pipe with 1 1/2" OD iron pipe with brass cap stamped -

No additional accessories established.

S-1/16 S29 | S28

S498
T36N, R10E

CPI-1975

Dated at Rhineland, Wis., this 19th day of September, 1975.

Signature Phillip T. Hansen Title Registered Land Surveyor Registration No. S-498
(County Surveyor, Registered Land Surveyor, or other duly authorized official)

Office of Register of Deeds, County of Oneida
Instrument was filed in this office for record on the 17th day of November, 1975
at 10:00 o'clock A. M.

Doris George Fuchler
(Register of Deeds)

By Doris George Fuchler Deputy

000620193

○ = Corner monument restored.