

CERTIFIED LAND CORNER RESTORATION


Index No. U-7

State of Wisconsin } ss.  
County of Oneida

I Phillip T. Hansen, do hereby  
certify that on the 30th day  
of July, 1976, I found  
evidence of the SC 1/16  
corner of section 29  
Township 36 North, Range  
10 East, Fourth Principal Meridian,

as described hereon; and that from this evidence  
I established a new monument and accessories  
as described hereon to perpetuate the original  
location of this corner.

Resident witnesses:  
Glen Barker  
Jim Claffia  
Herb Wagoner

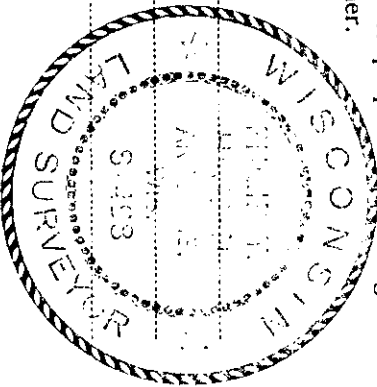

History of original corner establishment: Corner established by Ripco Surveyor, Drivas, in 1963. Ran random line North from S 1/4 Corner between sec. 29 and 32, a distance of 41.095 chains, closed out 347 chains East of C 1/4 corner set by H.C. Lawrence. Set SC 1/16 at point 17 1/2 chains west at 20.8485 chains, equidistant. Set iron pipe and marked BTs - 41m 10" N 48° W 1 ch and 41m 4" S 76° W 32 lks. H.C. Lawrence had set a new post for SC 1/16 in 1947, but did not mark any BTs.

Description of corner evidence found:

Unable to recover the iron pipe set by Ripco Surveyor.  
Recovered OBT - 41m 4" (7") S 76° W 32 lks, scribed CS 1/16 BT.

41m 10" (Red Maple 12", not 41m) N 48° W (N 54° W) 1 chain.

Recovered H.C. Lawrence's cedar post lodged between forks of a 12" maple on north bank of Pelican River, believed to have lodged there during flood of Pelican river.

was unable to locate old position of Corner from intersection of calls from OBT.

Description of monument and accessories I established to perpetuate the original location of this corner.

Set a 1 1/2" iron pipe with brass cap stamped.


Monument projects 12" above ground.

No suitable trees for BTs.

Set 1 1/2" iron pipe for reference mark 40 lks west, projects 2 ft.

Corner sets North 1 chain from North bank of Pelican river in tag alders.

3498  
T36N R10E  
S 29  
CPI-1976

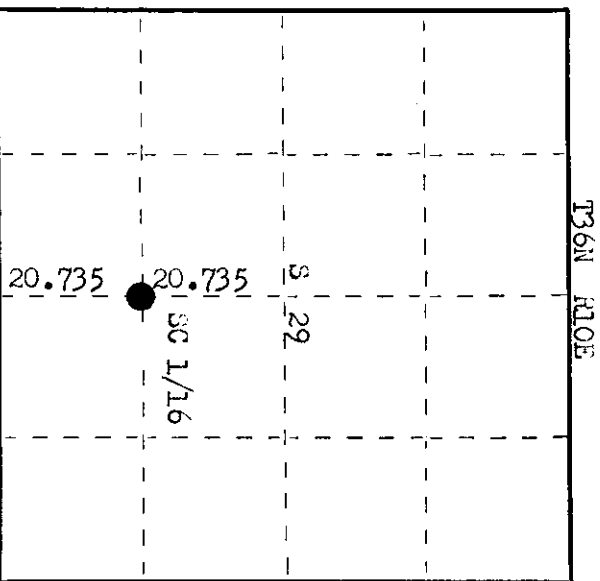

O = Corner monument restored.

Dated at Rhinelander, Wis., this 17th day of August, 1976

Signature: *Phillip T. Hansen* Title: Registered Land Surveyor Registration No. 5498  
(County Surveyor, Registered Land Surveyor, or other duly authorized official)

Office of Register of Deeds, County of Oneida. I hereby certify that the within instrument was filed in this office for record on the 30th day of September, 1976 at 10 o'clock P.M.

Signature: *Steve Fitzgerald*  
(Register of Deeds)

By: Deputy

3610291020