

CERTIFIED LAND CORNER RESTORATION

Index No. **719**

State of Wisconsin



County of Oneida } ss.

I Philip T. Hansen do hereby certify that on the 9th day of September 1975, I found evidence of the Quarter corner of Sections 28 and 29 Township 36 North, Range 10 East, Fourth Principal Meridian, as described hereon; and that from this evidence I established a new monument and accessories as described hereon to perpetuate the original location of this corner.

History of original corner establishment: Original corner established by Wm. E. Dougherty, Government Deputy Surveyor, in 1863 from which spruce 8" bears S21°E, 18 links and white pine 6" bears N15°W, 6 links. D.H. Vaughan, County Surveyor, recovered and restored this corner in 1905. Recovered original stump of white pine BT, N15°W, 6 links. Corner recovered and restored by H.C. Lawrence, Registered Land Surveyor, in 1948. Recovered an iron pipe and stump of original white pine. He set a new post and marked a dead white pine, N10°E, 44 links.

Resident witnesses:

Glen Barker  
Jim Glaflin

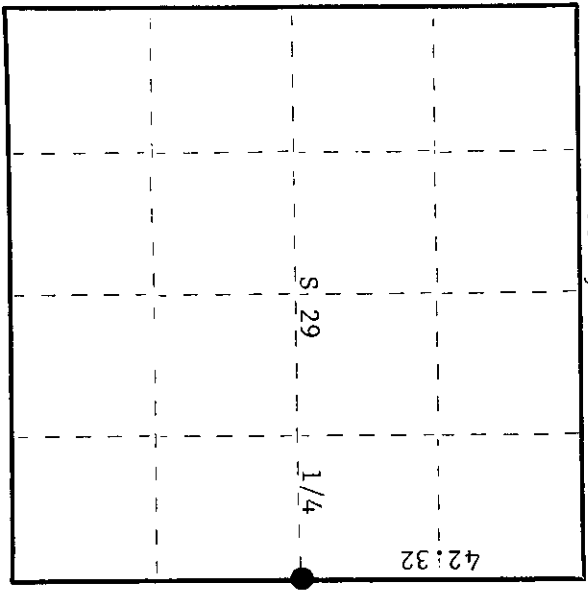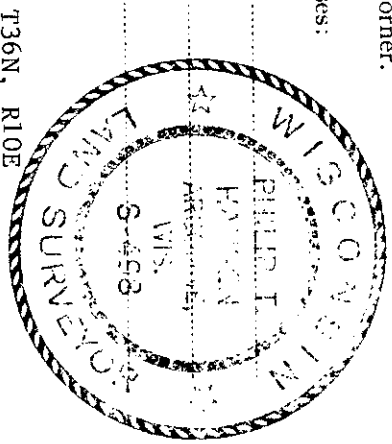

○ = Corner monument restored.

Description of corner evidence found:  
Recovered 4" cedar post, squared and scribed 1/4-S S28, 1/4-S S29, in poor condition.  
Also a 2 1/2" iron pipe with brass cap not scribed.

Recovered original white pine stump, N15°W, 6 links, now decayed. Lawrence apparently had refaced and rescribed it.  
Dead pine (white), N10°E, 44 links, fallen down and decayed, scribed 1/4-S BT.

Description of monument and accessories I established to perpetuate the original location of this corner.  
Reset recovered iron pipe 2 1/2" with brass cap as it was not set solid; stamped it - S498

NBT's - White birch 10" S20°W 27.2 links scribed 1/4 BT T36N, R10E  
White pine 8" S64°W 107.0 links scribed 1/4 BT S498

1/4 S29 | S28  
CPI-1975

Dated at Rhinelander Wis. this 19th day of September 1975

Signature *Philip T. Hansen* Title Registered Land Surveyor Registration No. S-498  
(County Surveyor, Registered Land Surveyor, or other duly authorized official)

Office of Register of Deeds, County of Oneida  
Instrument was filed in this office for record on the 17th day of September 1975  
at 10:00 o'clock A.M.

*Armeda Vernege Fuchler*  
(Register of Deeds)

By Deputy

3610292000