

CERTIFIED LAND CORNER RESTORATION

Index No. **77**



State of Wisconsin

County of Oneida } ss.

I, Phillip T. Hansen, do hereby certify that on the 9th day of September, 1975, I found evidence of the C-1/4 corner of Section 29, Township 36, North, Range 10 East, Fourth Principal Meridian, as described hereon, and that from this evidence I established a new monument and accessories as described hereon to perpetuate the original location of this corner.

Resident witnesses:

Glen Barker
Jim Claflin

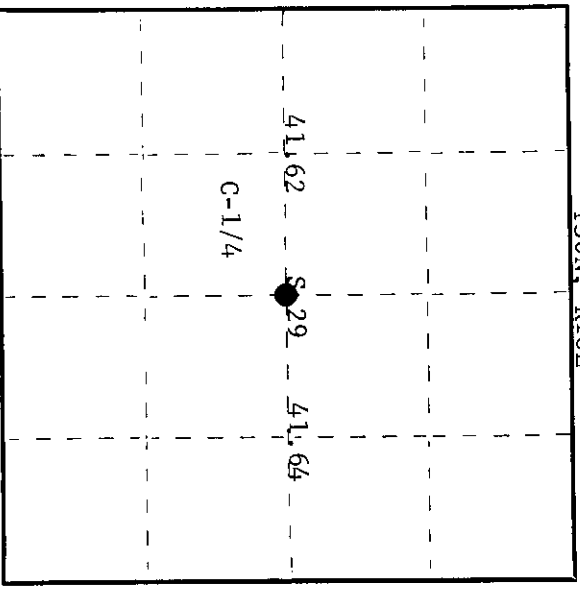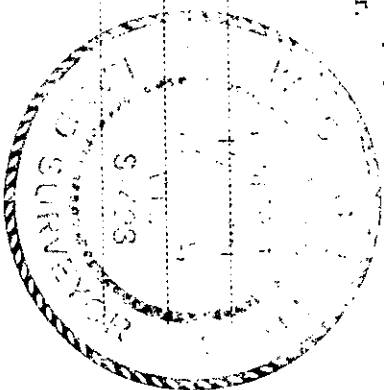

○ = Corner monument restored.

History of original corner establishment: Corner established by D.H. Vaughan, County Surveyor, in 1897 from intersection of N-S and E-W quarter lines. Set a wooden post from which tamarack 12" bears N39½°W, 16 links and spruce 8" bears S44°E, 13½ links. Corner recovered and restored by H.C. Lawrence, Registered Land Surveyor, in 1948. Recovered Vaughan's old post and 3' stump of Vaughan's tamarack BT, N39½°W, 16 links and stump of spruce 8", S44°E, 13½ links. Set new cedar post and marked NBT's spruce 6", S21°W, 25 links and spruce 8", N55°E, 26 links.

Description of corner evidence found:
Recovered 6" cedar post, squared and scribed C-1/4-S S29, C-1/4-S S29, in poor condition. Also an old cedar point lying beside it.
Recovered OBT's - Spruce 8" S44°E 13½ links - now a decayed stump
Tamarack 12" N39°W 16 links - now a decayed stump
B. spruce 6" S21°W 25 links - blown down and dead; scribed C-1/4 S29
B. spruce 8" N55°E 26 links - a 2' stub; scribed NBT

Description of monument and accessories I established to perpetuate the original location of this corner.
Replaced 6" cedar post with 2½" iron pipe with brass cap stamped -

NBT's - B1. spruce 6" N79°W 22.4 links - scribed C-1/4 BT
B1. spruce 6" S27°W 25.2 links - scribed C-1/4 BT
S498
T36N, R10E
C-1/4 S 29
CPI-1975

Dated at Rhineland, Wis., this 19th day of September, 1975.

Signature Phillip T. Hansen Title Registered Land Surveyor Registration No. S-498
(County Surveyor, Registered Land Surveyor, or other duly authorized official)

Office of Register of Deeds, County of Oneida
Instrument was filed in this office for record on the 17th day of November, 1975
at 10:08 o'clock A.M.

Dorcas Verage Fischer
(Register of Deeds)

By: _____ Deputy

2022520193