



CERTIFIED LAND CORNER RESTORATION

Index No. **V 5**

State of Wisconsin }  
 County of Oneida } ss.

I Philip T. Hansen, do hereby certify that on the 11th day of September 1975, I found evidence of the Section Corner corner of S29, S30, S31, and S32 Township 36 North, Range 10E, Fourth Principal Meridian, as described hereon; and that from this evidence I established a new monument and accessories as described hereon to perpetuate the original location of this corner.

Resident witnesses:  
 Glen Barker  
 Jim Clafflin

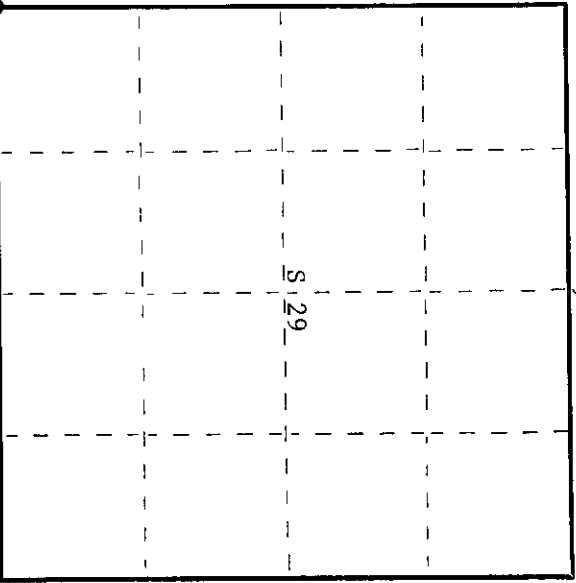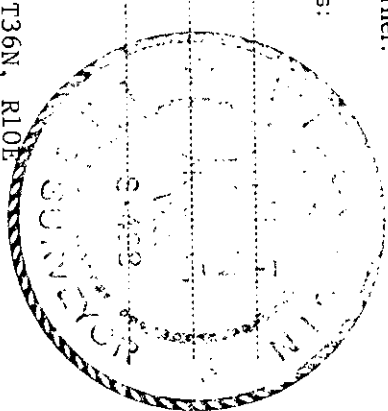

○ = Corner monument restored.

History of original corner establishment:

Original corner established by Wm. E. Dougherty, Gov. Deputy Surveyor, in 1863 from which hemlock 20" bears S66°E 17 links and ash 18" bears N40°W 9 links. Corner recovered and restored by H.C. Lawrence, Reg. Land Surveyor, in 1947 during his retracement survey. Recovered remains of original ash BT. Tree was down and badly rotted but found remains of old facing with scribe marks and from this located point of old stake in a wet hole. Set new cedar post and marked NBT's. Cedar 12" N60°W, 69-1/2 links, and cedar 7" S37°W, 63 links. A tamarack stub 50" high, blazed and notched, bears N45°E 24-1/2 links.

Description of corner evidence found:

Recovered a 6" cedar post, squared and scribed S29 S30 T36N, S31 R10E S32 in fair condition. OBT original ash 18" N40°W now a decayed mound. A cedar post scribed BT has been driven in center of mound. A tamarack 24" x 50' high N45°E 24.5 links has fallen down and decayed. No scribe marks visible.  
 Cedar 12" N60°W 69.5 links Now a cut-off stump.  
 Cedar 7" S37°W 63 links Now a cut-off stump.

Description of monument and accessories I established to perpetuate the original location of this corner.  
 Replaced wood post with 2-1/2" iron pipe with brass cap stamped -

|     |               |       |            |               |              |
|-----|---------------|-------|------------|---------------|--------------|
| NBT | Black ash 8"  | N4°W  | 18 links   | Scribed SC BT | S498         |
|     | Black ash 10" | S16°E | 42.6 links | Scribed SC BT | T36N R10E    |
|     | Cedar 9"      | N63°E | 33.3 links | Scribed SC BT | 30   29      |
|     |               |       |            |               | Sec. 31   32 |

CPI-1975

Dated at Rhinelander, Wis., this 22nd day of September, 1975.

Signature *Philip T. Hansen* Title Registered Land Surveyor Registration No. S-498  
 (County Surveyor, Registered Land Surveyor, or other duly authorized official)

Office of Register of Deeds, County of Oneida  
 at 10:00 o'clock A.M. 17th day of November 1975  
 I hereby certify that the within

*Dona Savage Fiedler*  
 Register of Deeds

By: Deputy

3610300000