

CERTIFIED LAND CORNER RESTORATION

Index No. 0-5

State of Wisconsin

County of Oneida } ss.


History of original corner establishment:
1979 P.T. Hansen perpetuated H.C. Lawrence's post with a 1" iron pipe monument.

I, Glen Barker, do hereby certify that on the 14th day of June, 1984, I ~~renewed~~ established the corner of Sections 29 & 30 Township 36 North, Range 10 East, Fourth Principal Meridian, as described hereon; and that from this evidence I established a new monument and accessories as described hereon to perpetuate the original location of this corner.


Resident witnesses:

N. Spiess

H. Wagoner

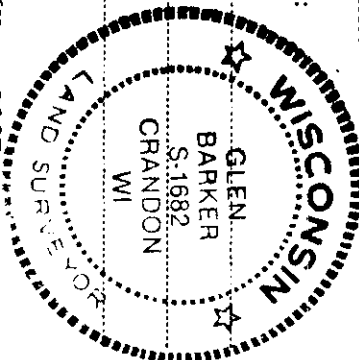

T36N R10E

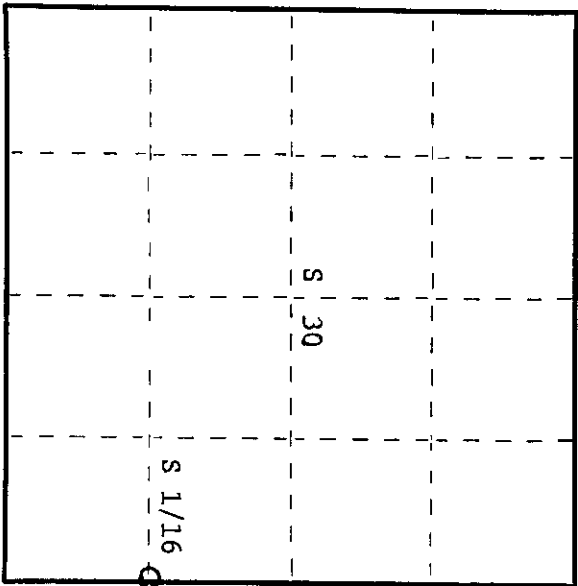

○ = Corner monument restored.

Description of corner evidence found:

Total distance from section corner 29, 30, 31, 32 to 1/4 corner between sections 29 & 30 is 2739.32'.
Set S 1/16 1369.66' intermediate.
New established monument bears S87E 3.00' of H.C. Lawrence's position.

Description of monument and accessories I established to perpetuate the original location of this corner.
Set a 1" iron pipe with 2" diameter alloy cap, stamped:
Monument projects 18" above ground.
Ties to P.T. Hansen's B.T.

Cedar 12" N81E 42.12' S1682
Tamarack 10" S69E 30.24' T36N R10E
S 1/16 30 29
CPI-1984

Dated at Rhineland, Wis., this 7th day of August, 1984

Signature: *Glen Barker* Title: Registered Land Surveyor Registration No. S1682
(County Surveyor, Registered Land Surveyor, or other duly authorized official)
Office of Register of Deeds, County of Oneida
Instrument was filed in this office for record on the 10th day of December, 1984
at 11:30 o'clock A.M.

Doree Savage Kunkin
(Register of Deeds)

By: Deputy

3610 301000