

CERTIFIED LAND CORNER RESTORATION

Index No. 7-4

State of Wisconsin

County of Oneida } ss.

I Glen Barker, do hereby

certify that on the 14th day

of June, 1984, I found

~~established~~ the EC 1/16

corner of Section 30

Township 36, North, Range



10 East, Fourth Principal Meridian,

as described hereon; and that from this evidence I established a new monument and accessories as described hereon to perpetuate the original location of this corner.

Resident witnesses:

N. Spiess

H. Wagoner

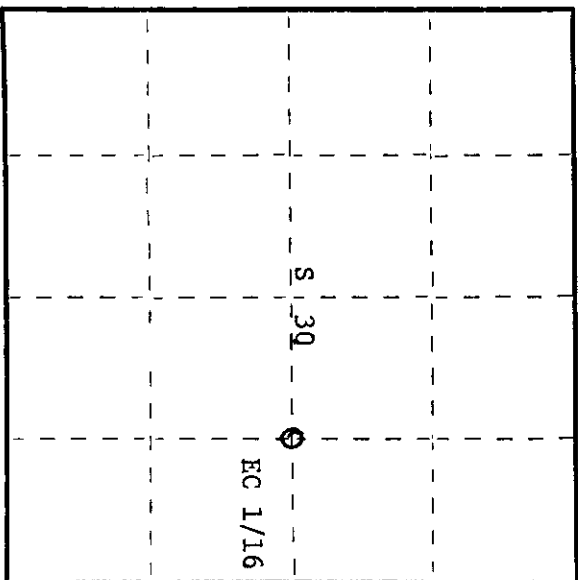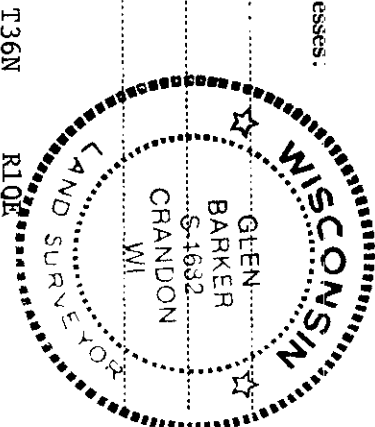

○ = Corner monument restored.

History of original corner establishment:

No evidence of any previous corner.

Description of corner evidence found:

Total distance from 1/4 corner between sections 29 and 30 to C 1/4 Section 30 is 2583.32'.

Set EC 1/16 1291.66' intermediate.

Description of monument and accessories I established to perpetuate the original location of this corner.

Set a 1" iron pipe with 2" diameter alloy cap, stamped: Monument projects 18" above ground.

Marked NBTs:

Maple 5" S41E 41.46'

White Spruce 4" N68W 23.30'

scribed 1/16 - B.T.

S1682

T36N R10E

S 30

EC 1/16

CPI-1984

Dated at Rhineland, Wis., this 7th day of August, 1984

Signature Glen Barker Title Registered Land Surveyor Registration No. S1682
(County Surveyor, Registered Land Surveyor, or other duly authorized official)

Office of Register of Deeds, County of Oneida I hereby certify that the within instrument was filed in this office for record on the 10th day of December, 1984 at 11:30 o'clock A. M.

Tonia Verage Tucker
(Register of Deeds)

By Tonia Verage Tucker Deputy

3610302010