

CERTIFIED LAND CORNER RESTORATION

Index No. T-2

State of Wisconsin


County of Oneida } ss.

History of original corner establishment:
Old post bears S77E 17.80' of new established corner.

I, Glen Barker, do hereby certify that on the 13th day of June, 1984, I ~~renewed~~ ~~reestablished~~ the WC 1/16 corner of Section 30, Township 36, North, Range 10 East, Fourth Principal Meridian, as described hereon; and that from this evidence I established a new monument and accessories as described hereon to perpetuate the original location of this corner.

Description of corner evidence found:
Corner established by a point established where the E-W 1/4 line of section 30 intersects the N-S 1/4 line of the NW 1/4. WC 1/16 sets 1283.46' of C 1/4 and 1323.12' of 1/4 corner between sections 25 & 30 T36N R9&10E.


Resident witnesses:
N. Spiess
H. Wagoner

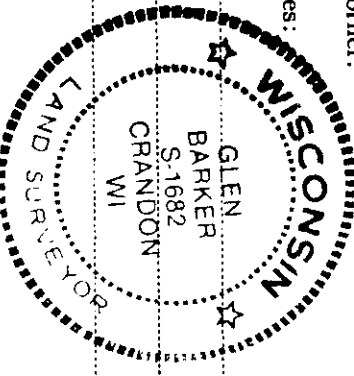

Description of monument and accessories I established to perpetuate the original location of this corner.

Set a 1" iron pipe with 2" diameter alloy cap, stamped:
Monument projects 18" above ground.

Marked NBTs:
Sugar 6" S88W 3.4' S1682
Sugar 7" N35E 13.18' T36N R10E
scribed 1/16-B.T. WC 1/16 S 1-30
CPI - 1984

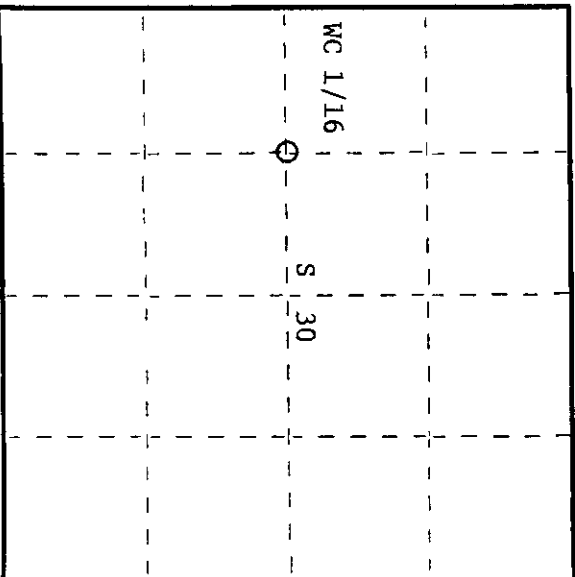

O = Corner monument restored.

Dated at Rhinelander, Wis., this 13th day of August, 1984

Signature: *Glen Barker* Title: Registered Land Surveyor Registration No. S1682
(County Surveyor, Registered Land Surveyor, or other duly authorized official)

Office of Register of Deeds, County of Oneida, hereby certify that the within instrument was filed in this office for record on the 10th day of December, 1984 at 1:30 o'clock P.M.

Signature: *Doris George Coulter*
(Register of Deeds)

By: _____ Deputy

3610302030