

State of Wisconsin }
County of Oneida } ss.

CERTIFIED LAND CORNER RESTORATION

Index No. S - 2

History of original corner establishment:

No evidence of any previous corner.


I, Glen Barker, do hereby certify that on the 10th day of July, 1984, I know evidence of the NW 1/16 corner of Section 30 Township 35 North, Range 10 East, Fourth Principal Meridian, as described hereon; and that from this evidence I established a new monument and accessories as described hereon to perpetuate the original location of this corner.

Description of corner evidence found:

Corner established by subdivision of the NW 1/4.
Corner sets 1370.71' of NC 1/16 and 1333.07' of WC 1/16.

Resident witnesses:


N. Spless
H. Wagoner

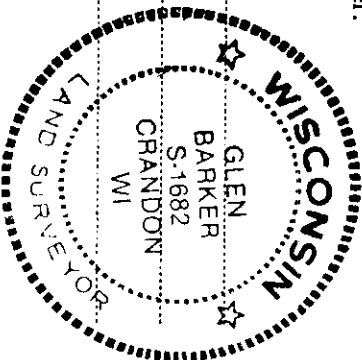

Description of monument and accessories I established to perpetuate the original location of this corner.

Set a 1" iron pipe with 2" diameter alloy cap, stamped:
Monument projects 18" above ground.

Marked NRTs:
Red Pine 16" S75W 4.02' S1682
Sugar 12" S22E 9.03' T36N R10E
scribed 1/16 B.T. NW 1/16 S 30
CPI-1984

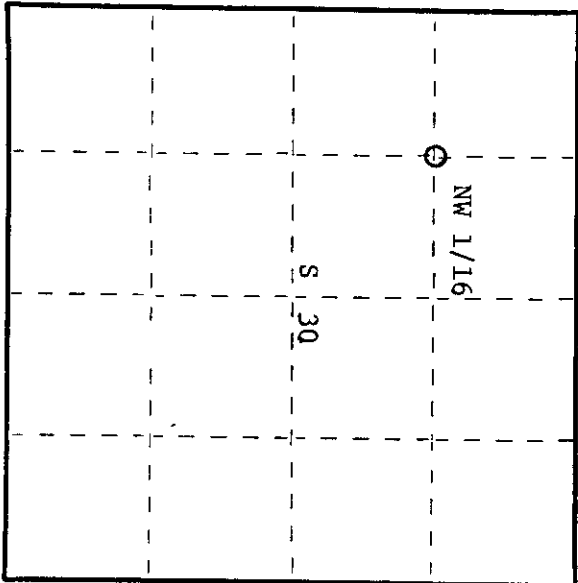

○ = Corner monument restored.

Dated at Rhinelander, Wis., this 8th day of August, 1984.

Signature: Glen Barker Title: Registered Land Surveyor Registration No. S1682
(County Surveyor, Registered Land Surveyor, or other duly authorized official)

Office of Register of Deeds, County of Oneida, I hereby certify that the within instrument was filed in this office for record on the 10th day of December, 1984 at 11:30 o'clock A.M.

Doris Leverage Hunter
(Register of Deeds)

By: _____ Deputy

361030 3030