

State of Wisconsin

County of Oneida

ss.


I, Phillip T. Hansen, do hereby certify that on the 10th day of January, 19 78, I found evidence of the Section corner of Secs. 31, 32, 5 & 6 Township 36 - 35, North, Range 10 East, Fourth Principal Meridian, as described hereon; and that from this evidence I established a new monument and accessories as described hereon to perpetuate the original location of this corner.

Resident witnesses:


Glen Barker

Jim Clafflin

Herb Wagoner

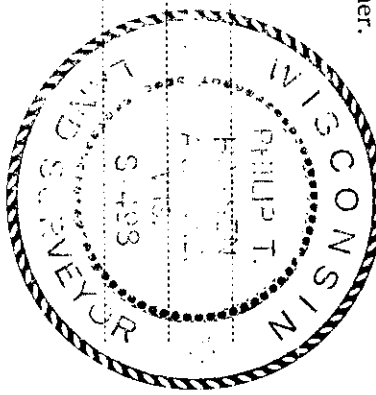

T35N R10E

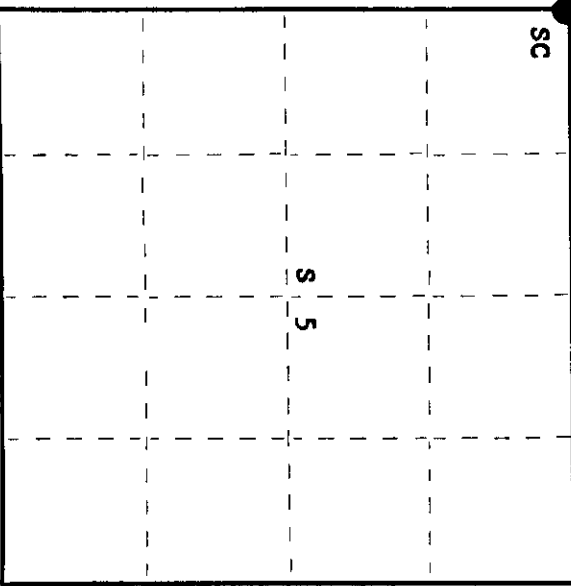

○ = Corner monument restored.

History of original corner establishment: Original Corner established by Hiram C. Fellows, Deputy Surveyor, in 1859, from which Spruce 10" bears N45°W, 12 links; Spruce 7" bears N50°E, 11 links; Spruce 8" bears S45°E, 15 links; Spruce 8" bears S75°W, 20 links.

Corner re-established by N. Loftus, Ripco Surveyor, in 1959. Ran random line west from N 1/4 corner, section 5, 41.32 chains. Recovered two old stumps that correspond to original BT's.

- Marked NBT's - White Pine 14" S69°W, 77 links
- White Pine 13" N57°E, 34 links
- Hemlock 13" bears N27°W 65 links

Description of corner evidence found:

- Recovered a 5" cedar post, squared and scribed S5°E, 6, 31, 32 in poor condition.
- Recovered OBT's - White Pine 14" (16") S69°W (S75°W) 77 links (76.6 links), scribed T35N R10 S6 BT.

- White Pine 13" (16") N57°E, 34 links, scribed S32 BT.
- Hemlock 13" (15") N27°W, 65 links, scribed T36 R10 S31 BT.

Description of monument and accessories I established to perpetuate the original location of this corner.

Replaced 5" cedar post with 2 1/2" iron pipe with brass cap, stamped:

Monument projects 18" above ground.
Marked NBT - Cedar 9" S36°W, 45.8 links, scribed SC BT.

S498
T36N R10E
S31 S32
Sec. S6 S5
T35N R10E

Dated at Rhinelander, Wis., this 12th day of January, 19 78

Signature: Phillip T. Hansen Title: Registered Land Surveyor Registration No. S-498
(County Surveyor, Registered Land Surveyor, or other duly authorized official)

Office of Register of Deeds, County of Oneida
Instrument was filed in this office for record on the 30th day of January, 19 78
at 1:45 o'clock P. M.

Dorcas Verage Kuehn
(Register of Deeds)

By: _____ Deputy

00001219