CERTIFIED LAND CORNER RESTORATION

Index No. A-4

State of Wisconsin
County of ..... } ss.

I ....., do hereby certify that on the ..... day of ....., 19..., I found evidence of the ..... corner of ..... Township ....., North, Range ....., Fourth Principal Meridian, as described hereon; and that from this evidence I established a new monument and accessories as described hereon to perpetuate the original location of this corner.

Resident witnesses:

.....

.....

.....

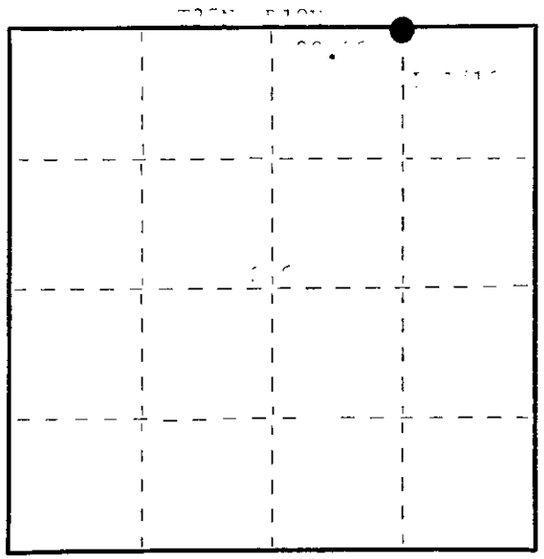

O = Corner monument restored.

History of original corner establishment:

.....

Description of corner evidence found:

.....

Description of monument and accessories I established to perpetuate the original location of this corner.

.....

Dated at ....., Wis., this ..... day of ....., 19...

Signature ..... Title ..... Registration No. .....
(County Surveyor, Registered Land Surveyor, or other duly authorized official)

Office of Register of Deeds, County of ..... I hereby certify that the within instrument was filed in this office for record on the 4th day of January, 19 78 at 2 o'clock P M.

Dorothy Verage Kuehn
(Register of Deeds)

By ..... Deputy

FORM 985 H. C. MILLER CO., MILWAUKEE

361031001